
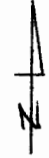


T. 26S, R. 5W, Sec. 30

POD
#1:
260' S,
140' E.

POD
#2:
245' S,
230' E.

both from
NW $\frac{1}{4}$ of
Sec. 30

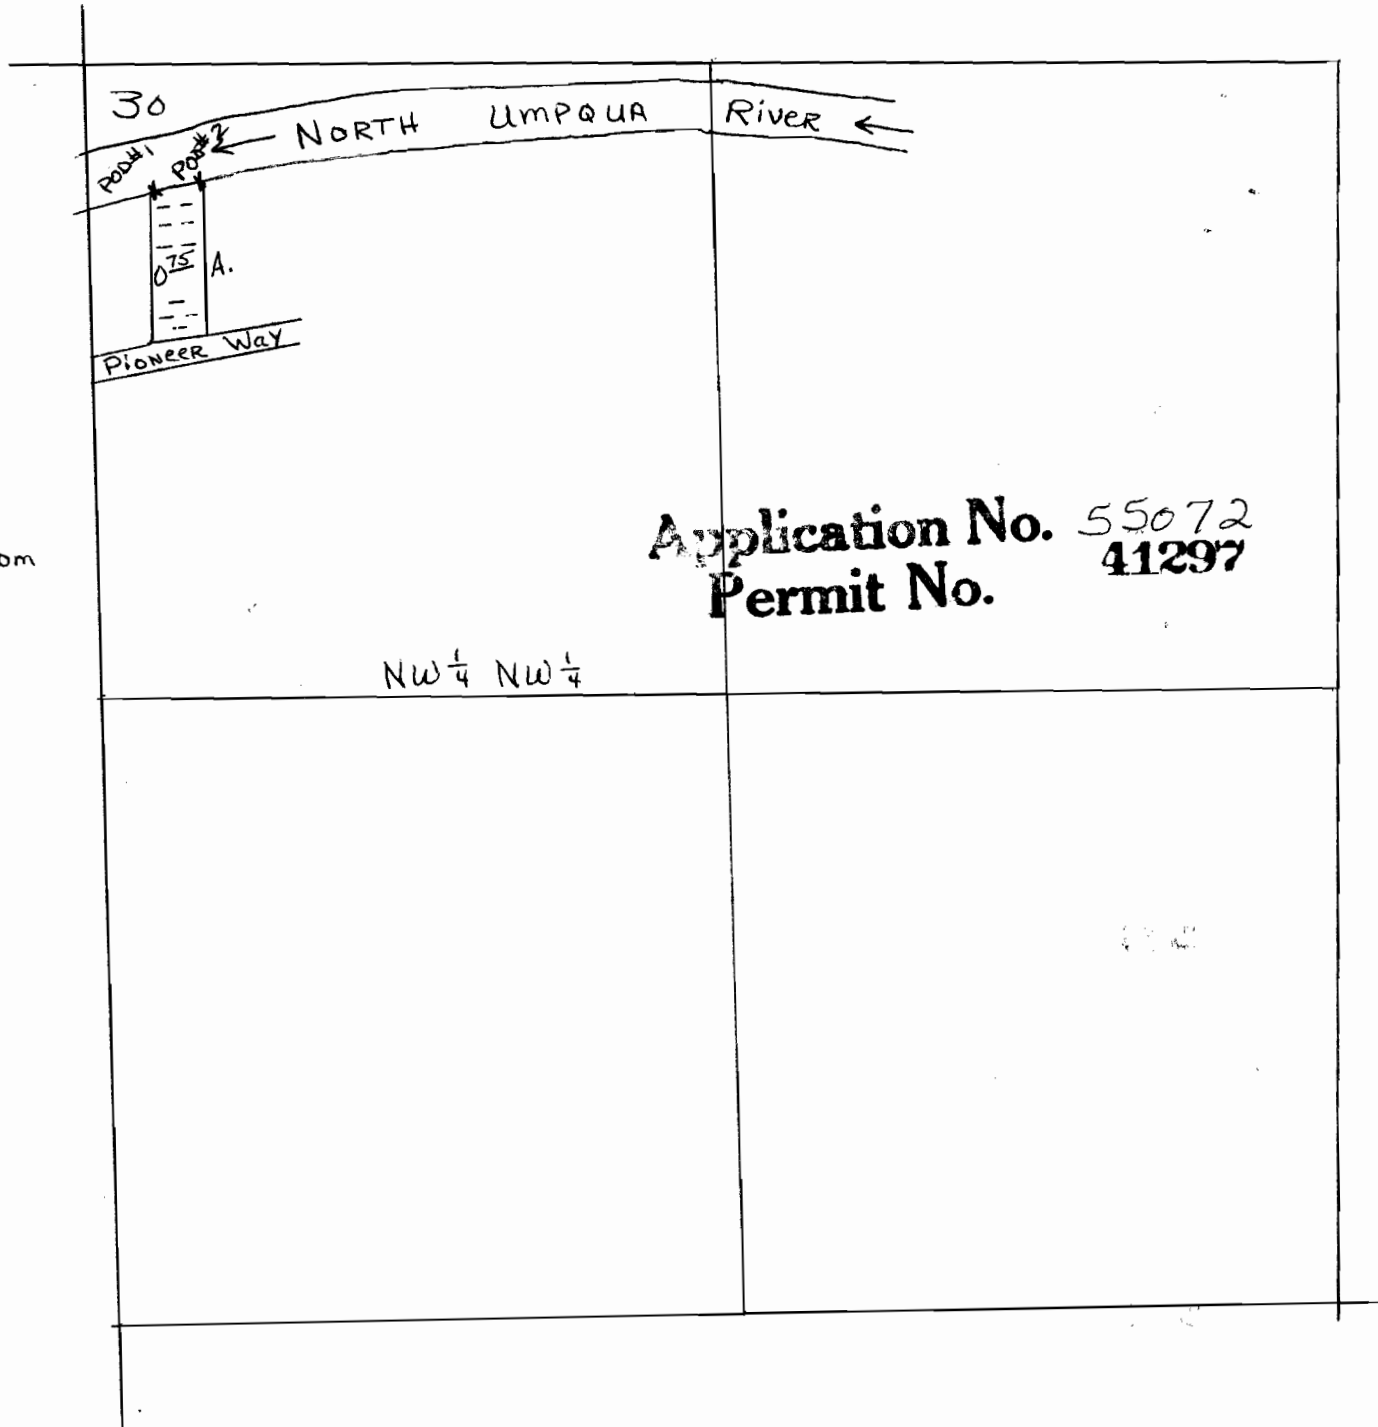

1" = 400'