


Township 16

Range 43

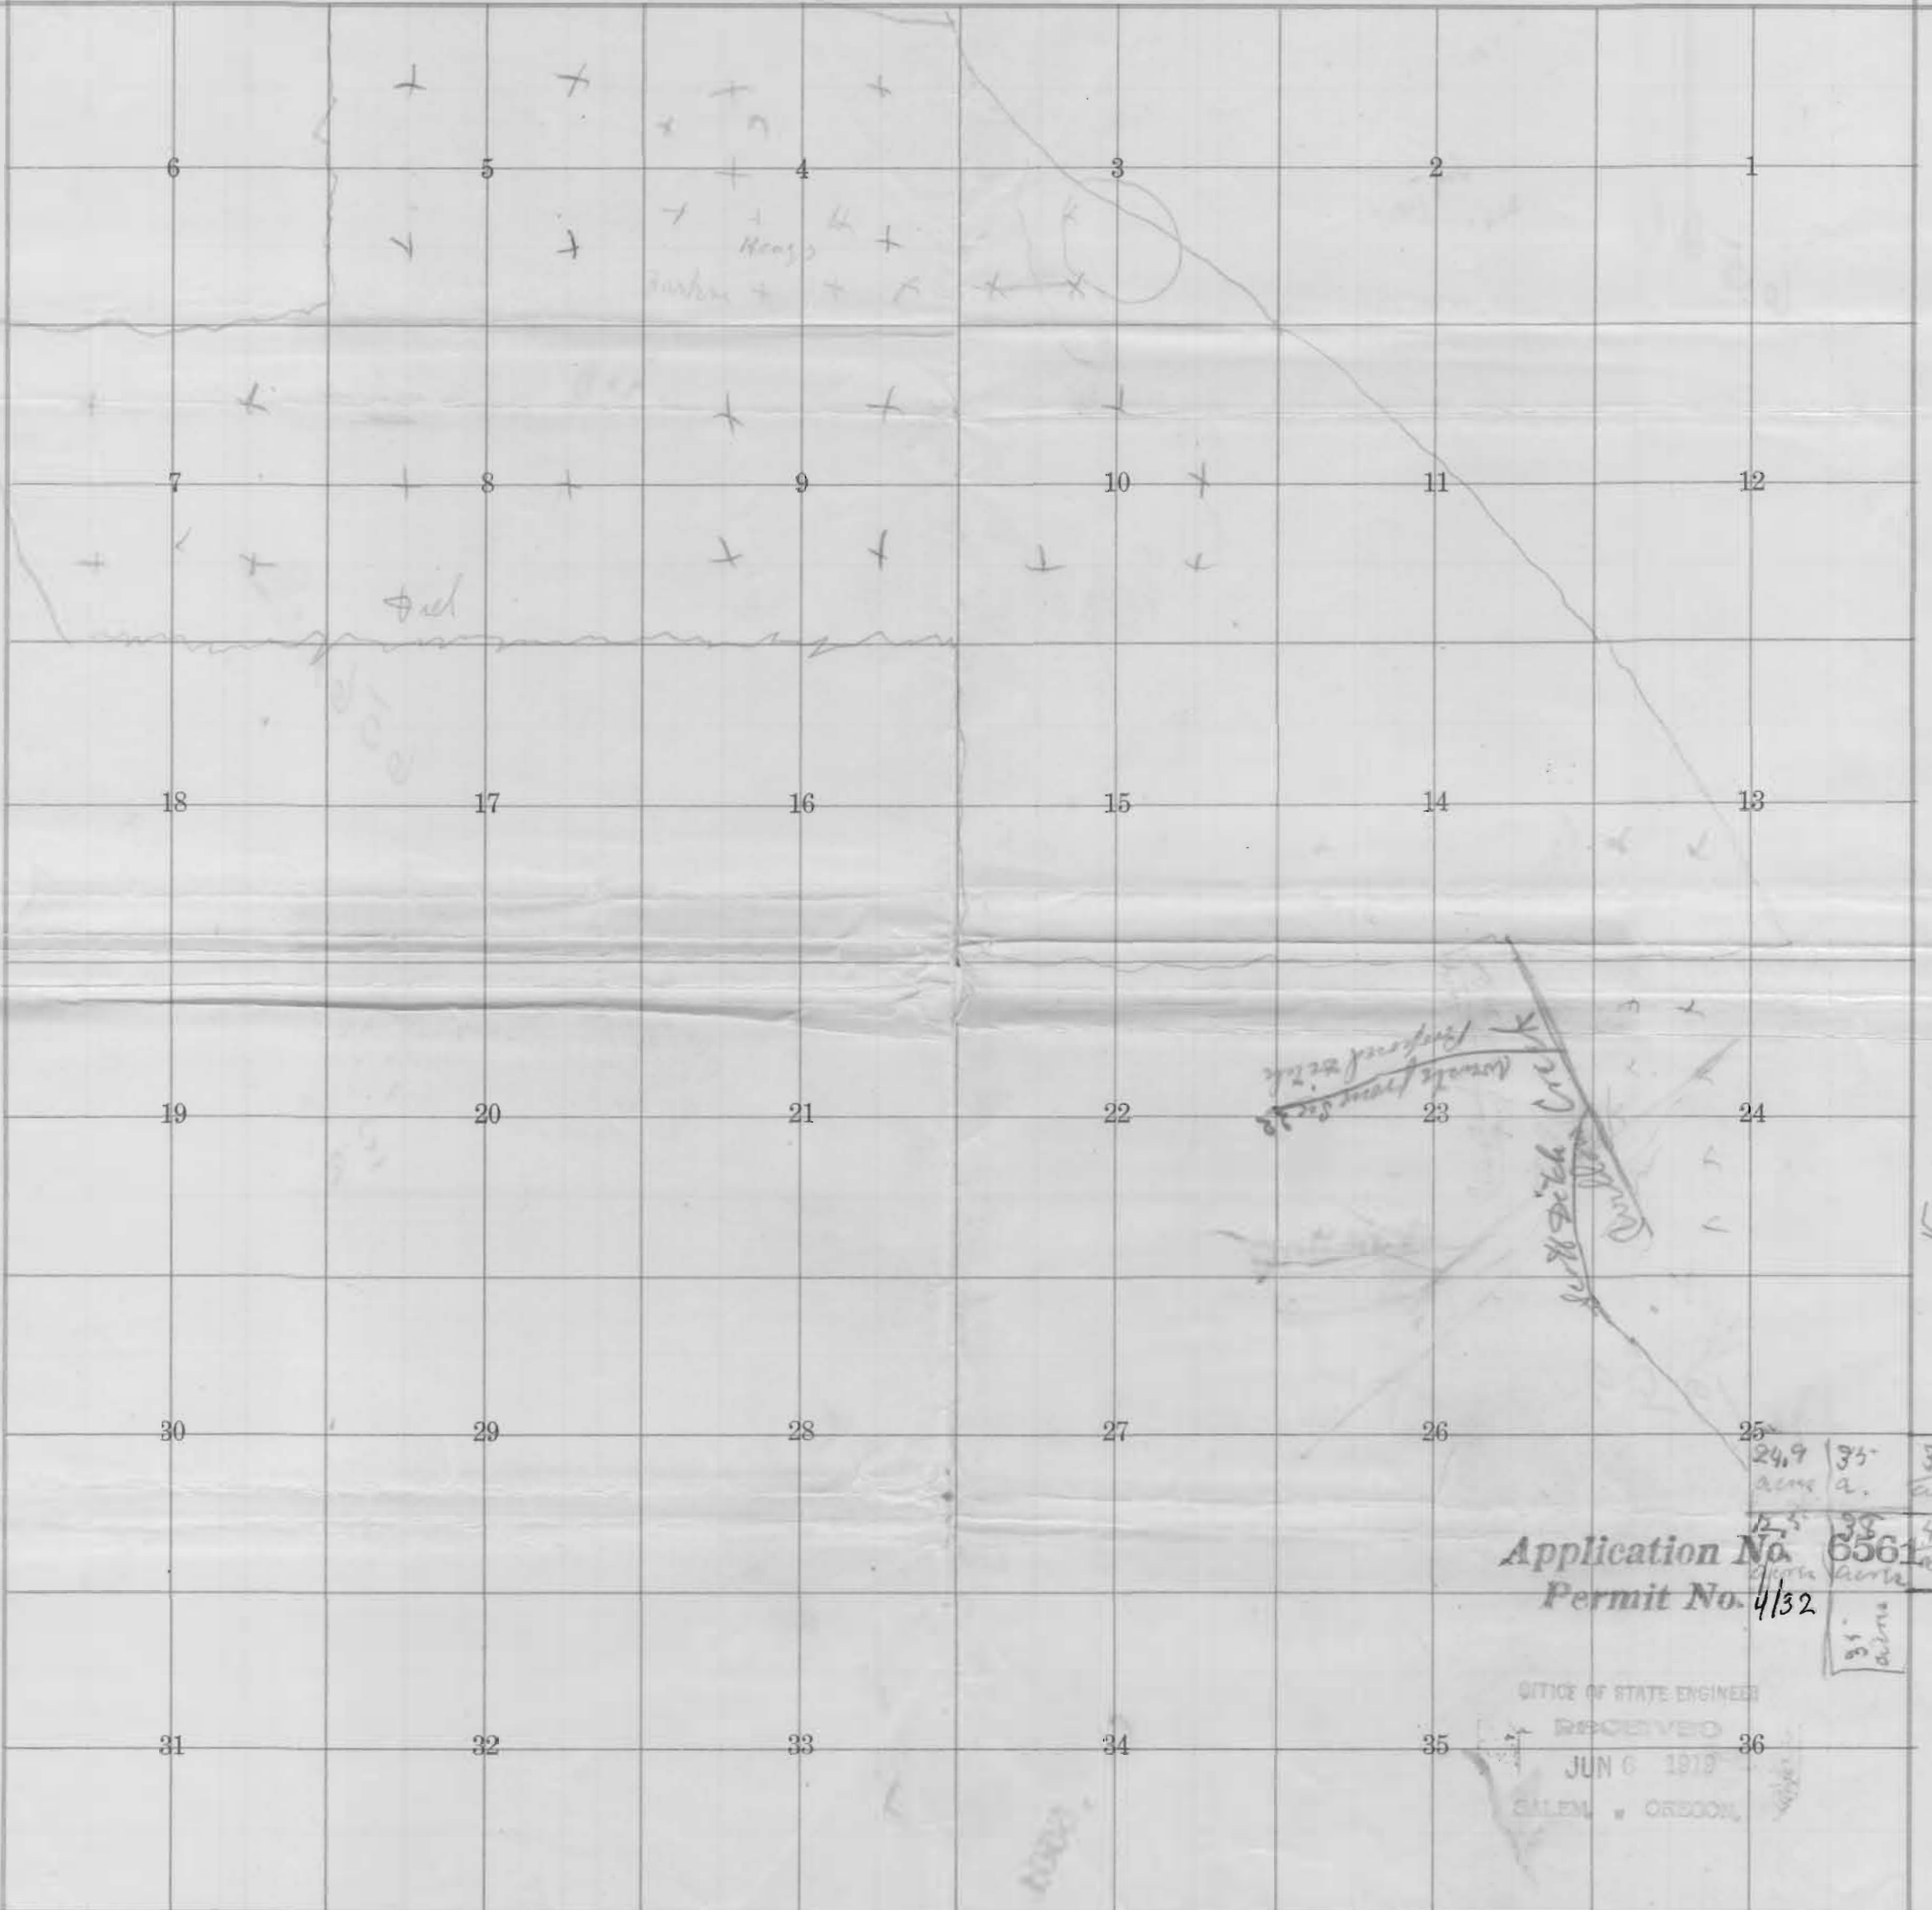

24.9	35	38
acres	a.	acres
12.5	38	40
acres	acres	acres
35		32
acres		acres

Application No. 6561
 Permit No. 4/32

OFFICE OF STATE ENGINEER
 RECEIVED
 JUN 6 1919
 SALEM, OREGON.

S. 30 1/2, 16 S.R. 44 E. W. 1/4

and 85 a. in the
 SW 1/4 S.R. 44