


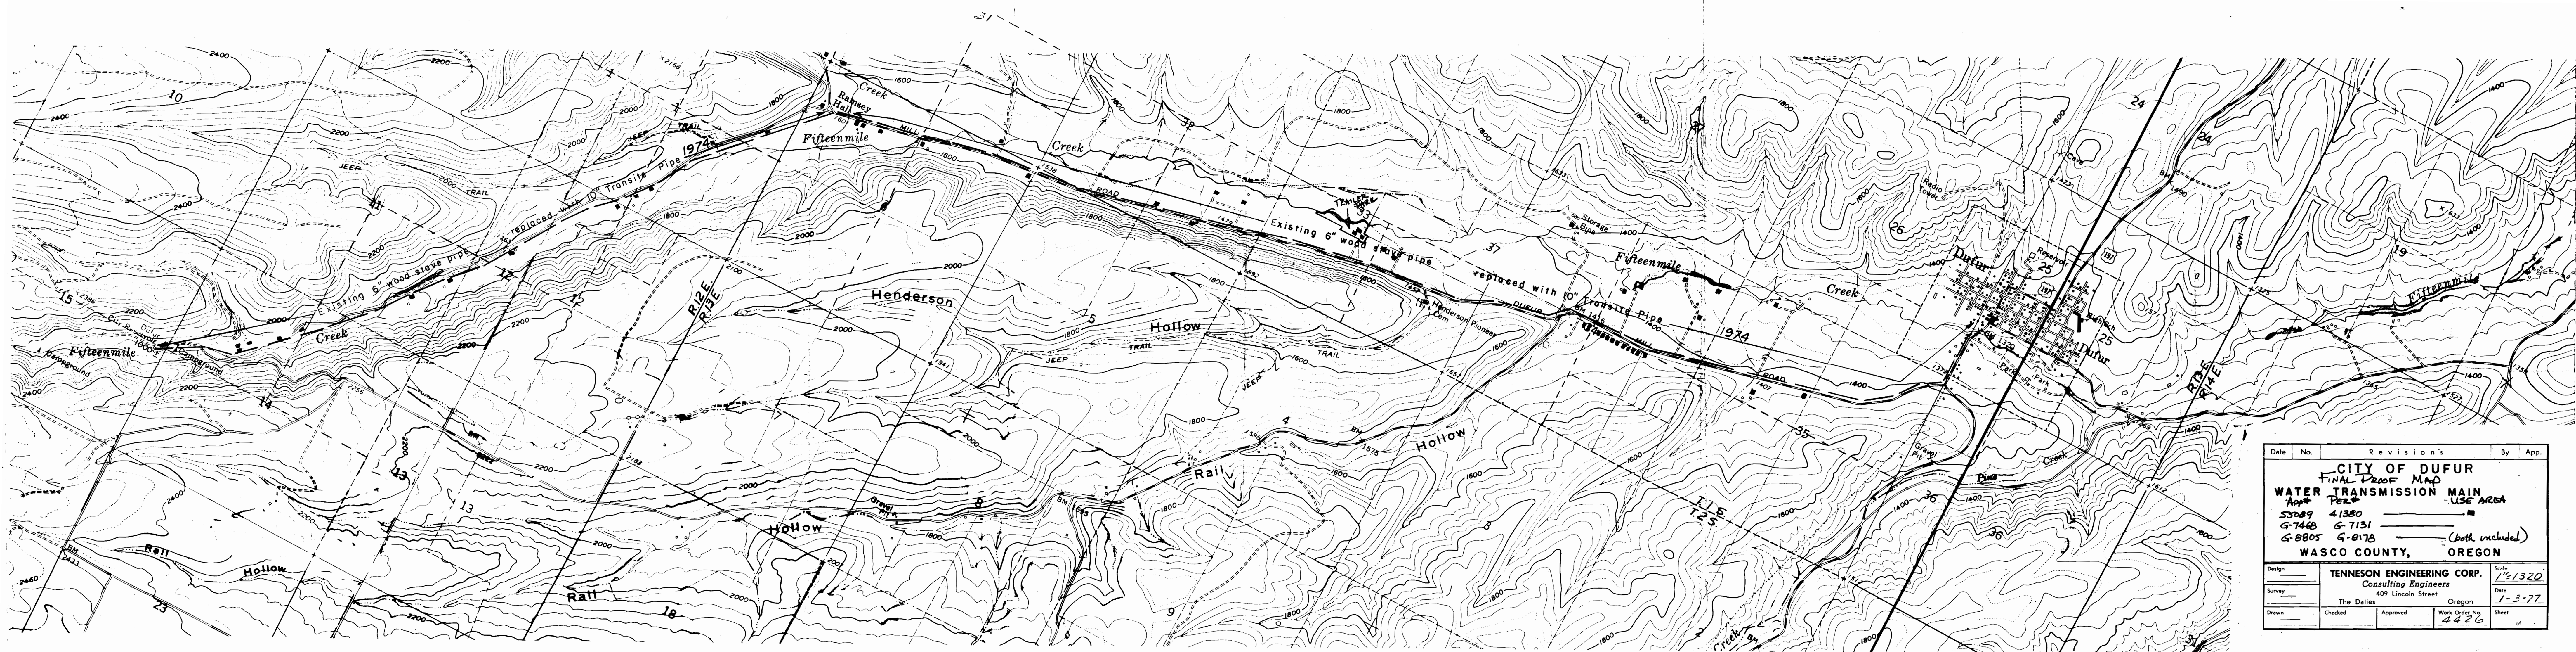

Date	No.	Revisions	By	App.
CITY OF DUFUR FINAL PROOF MAP WATER TRANSMISSION MAIN USE AREA				
App# 55089 41380				
G-7468 G-7131				
G-8805 G-8178 (both included)				
WASCO COUNTY, OREGON				
Design	TENNESON ENGINEERING CORP. Consulting Engineers 409 Lincoln Street The Dalles Oregon			Scale 1"=1320'
Survey				Date 1-3-77
Drawn	Checked	Approved	Work Order No. 4426	Sheet of

Application No. 55089
Permit No. 41380