


TOWNSHIP 25 SOUTH RANGE 12 WEST W.M.  
COOS COUNTY, ORE.

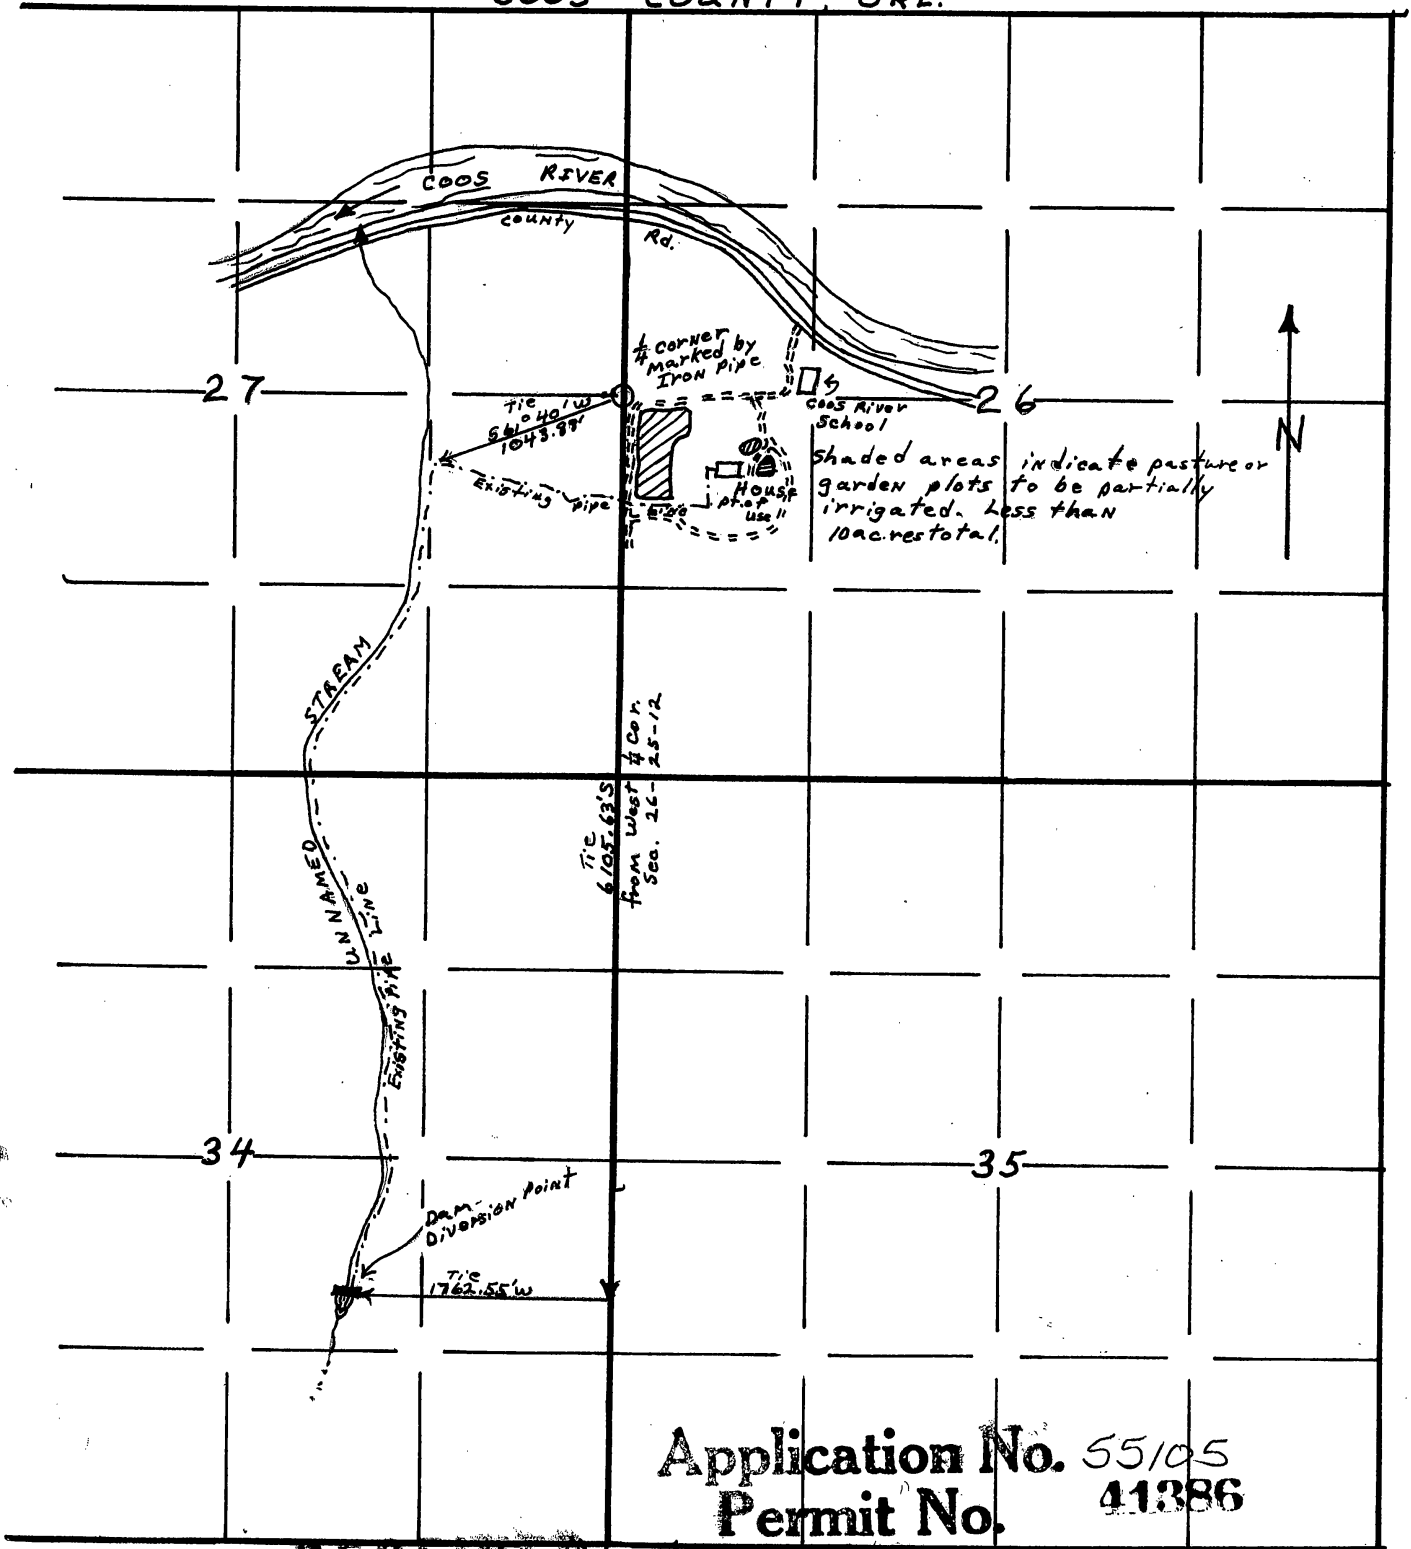

RECEIVED

JAN 14 1977

WATER RESOURCES DEPT  
SALEM, OREGON

Scale: 1" = 1320 ft.

Date: 1/10/77

Drawn By: RBE