RECEIVED
JAN 3 5 1977
...OURCES DEPT.
...OREGON

C
LAND TITI
This s
to assist
and the
guara

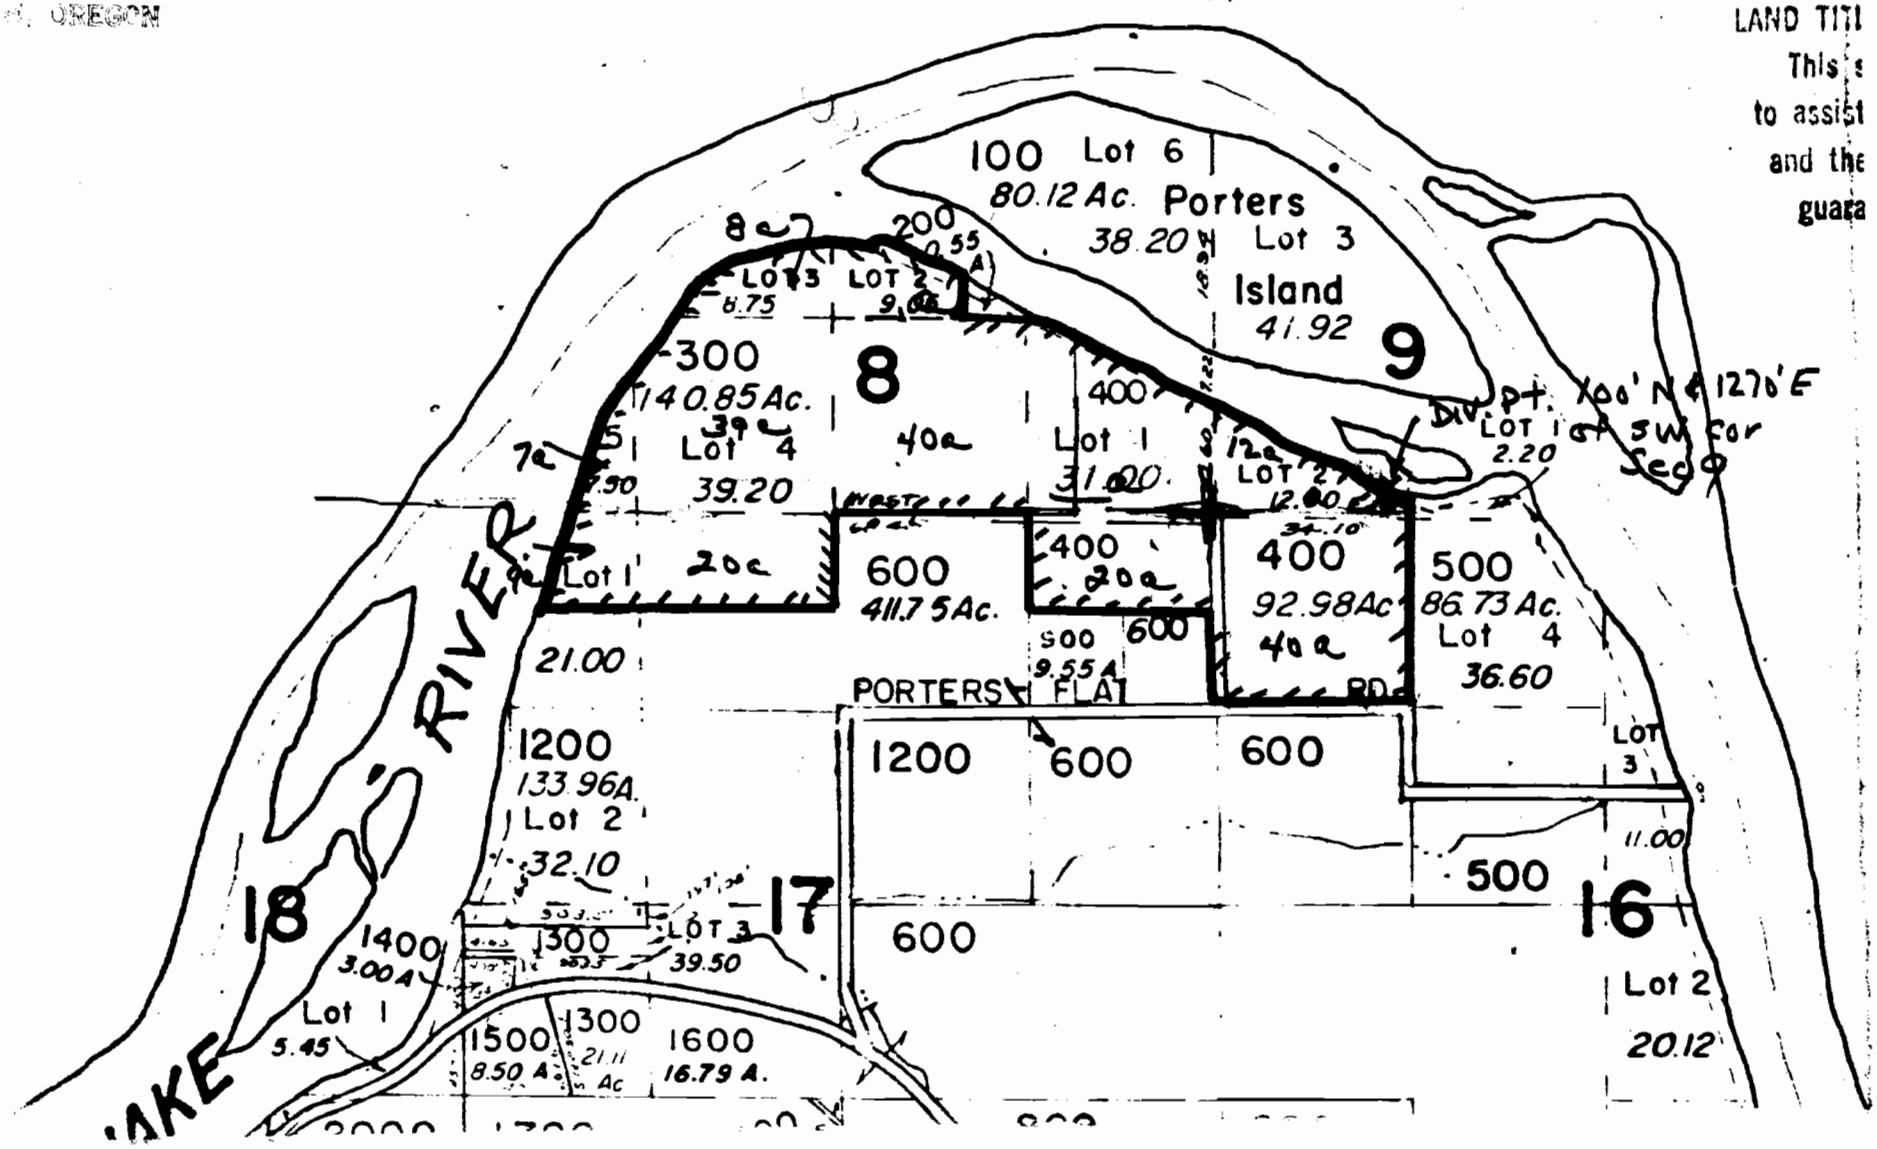

T15S R4E
1" = 1320'

Application No. 55149
Permit No. 41397

#55149