


T. 36 S.,  
R. 6 & 7 W.,  
W.M.

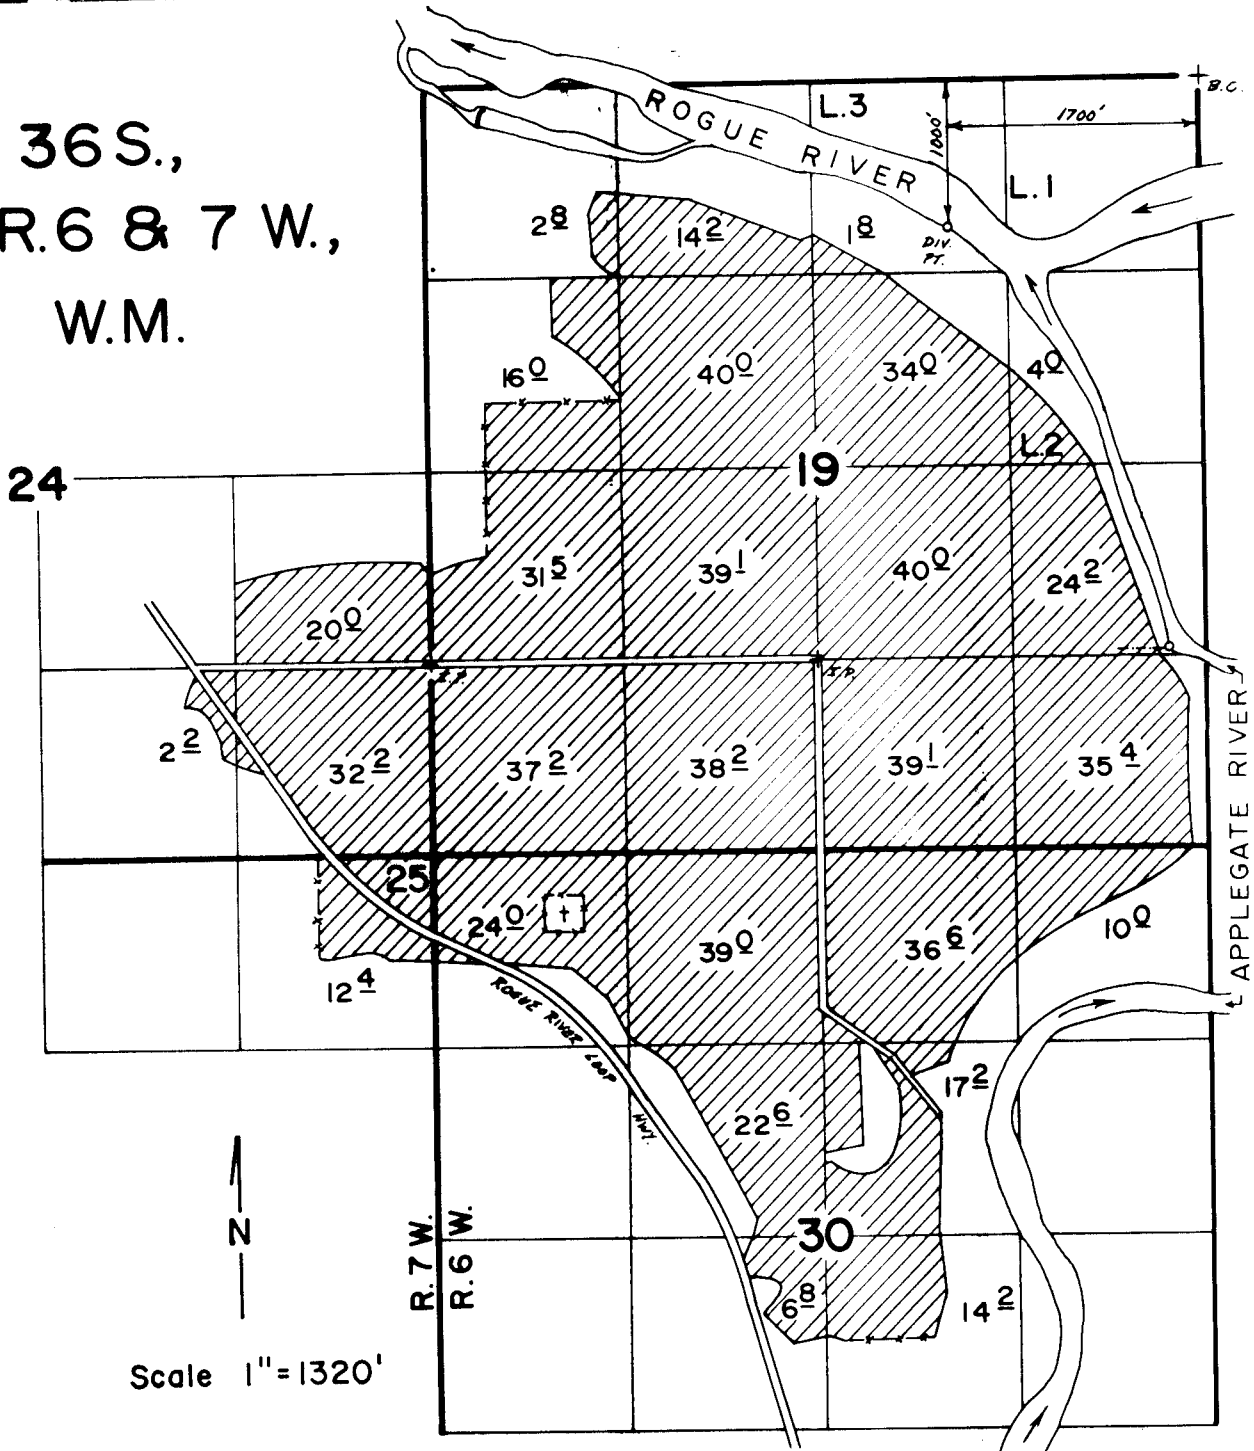

**FINAL PROOF SURVEY**  
UNDER

Application No. 55239. Permit No. 41420.....  
IN NAME OF

GENTRY E. MCKINNEY, SALVATORE T. PALMA, DAVID T. FAMA

Surveyed JAN. 24. 19.84, by B. S. JAMES.....

RECEIVED  
MAY 19 1987

WM. DIST. 14  
GRANTS PASS, ORE.