

RECEIVED


FEB 10 1977

WATER RESOURCES DEPT.
SALEM, OREGON



T. 27 S., R. 13 W., Sec. 2

1" = 200'

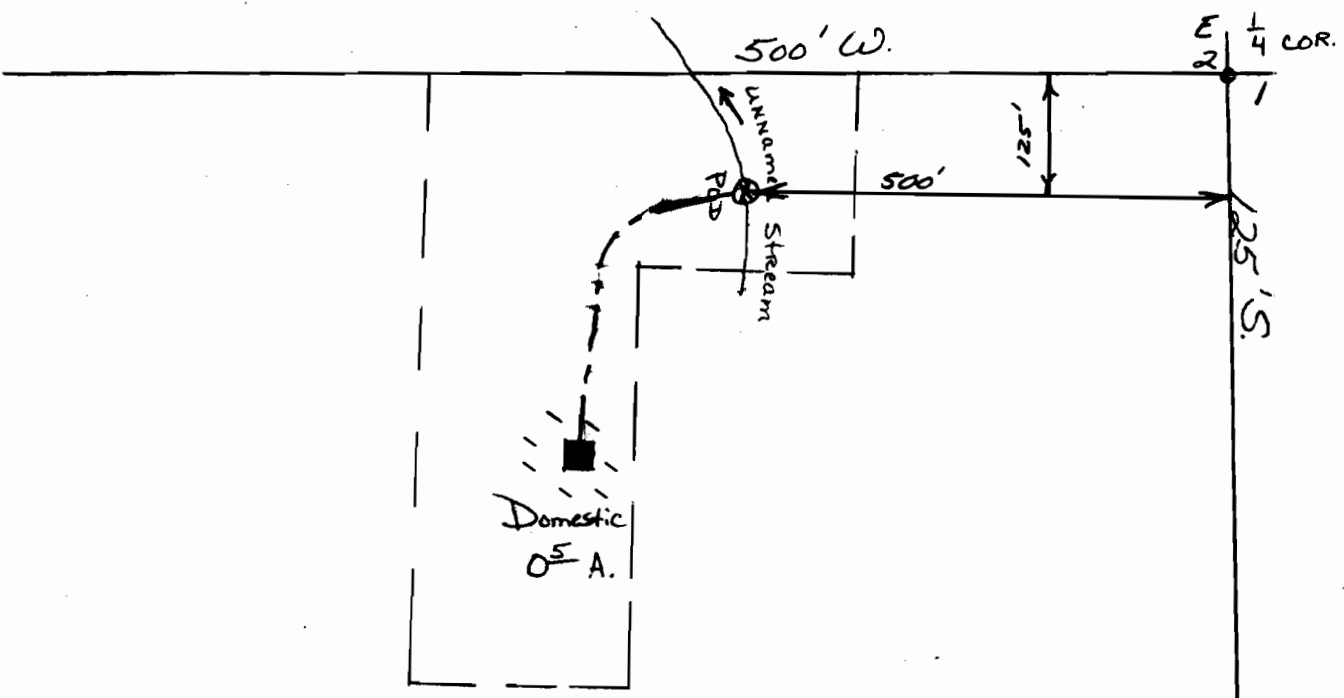

Application No. 55257
Permit No. 41421

NE 1/4 SE 1/4

Amif