

A 3537

P 1999

A-4286  
P-2468

OFFICE OF STATE ENGINEER


RECEIVED

JUL 1 1916

SALEM, OREGON,

Application No.  
Permit No.

5007  
2988

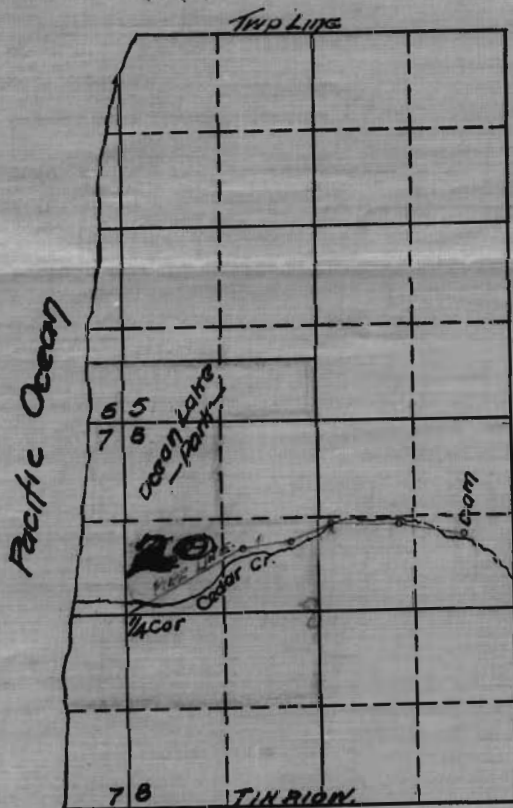

Description  
 Beginning at a point situated 1066 ft North and 4627.04 ft East of 1/4 corner between Sections 7 and 8 T1N R10 W W.M. The same being the location of the Headgate. Thence along Pipe Line as follows N 76° 34' W 921.17 ft. Thence S 86° 39' W 855.65 ft Thence S 69° 11' W 763.18 ft Thence S 85° 14' W 511.31 ft Thence S 61° 54' W 1882.67 to 1/4 cor between Sections 7 and 8 T1N R10 W W.M.

Water to be appropriated 3 Sec Ft.  
 Height of Dam 5 Ft.  
 Diameter of Pipe 12"  
 Difference of Elev. 234 Ft.

I C M Thomas of Portland Oregon do hereby certify that this map was made from notes taken during an actual survey made under my immediate supervision on Aug 6 and 7 1909 that it correctly represents the works described in the accompanying Application together with the location of Streams and other Ditches in the immediate vicinity

C M Thomas  
 Surveyor

Application # 261,  
 Permit # 122.

Application No. 6596

Permit No. 4147

2001