



T. 26 S. R. 5 W. Sec. 16

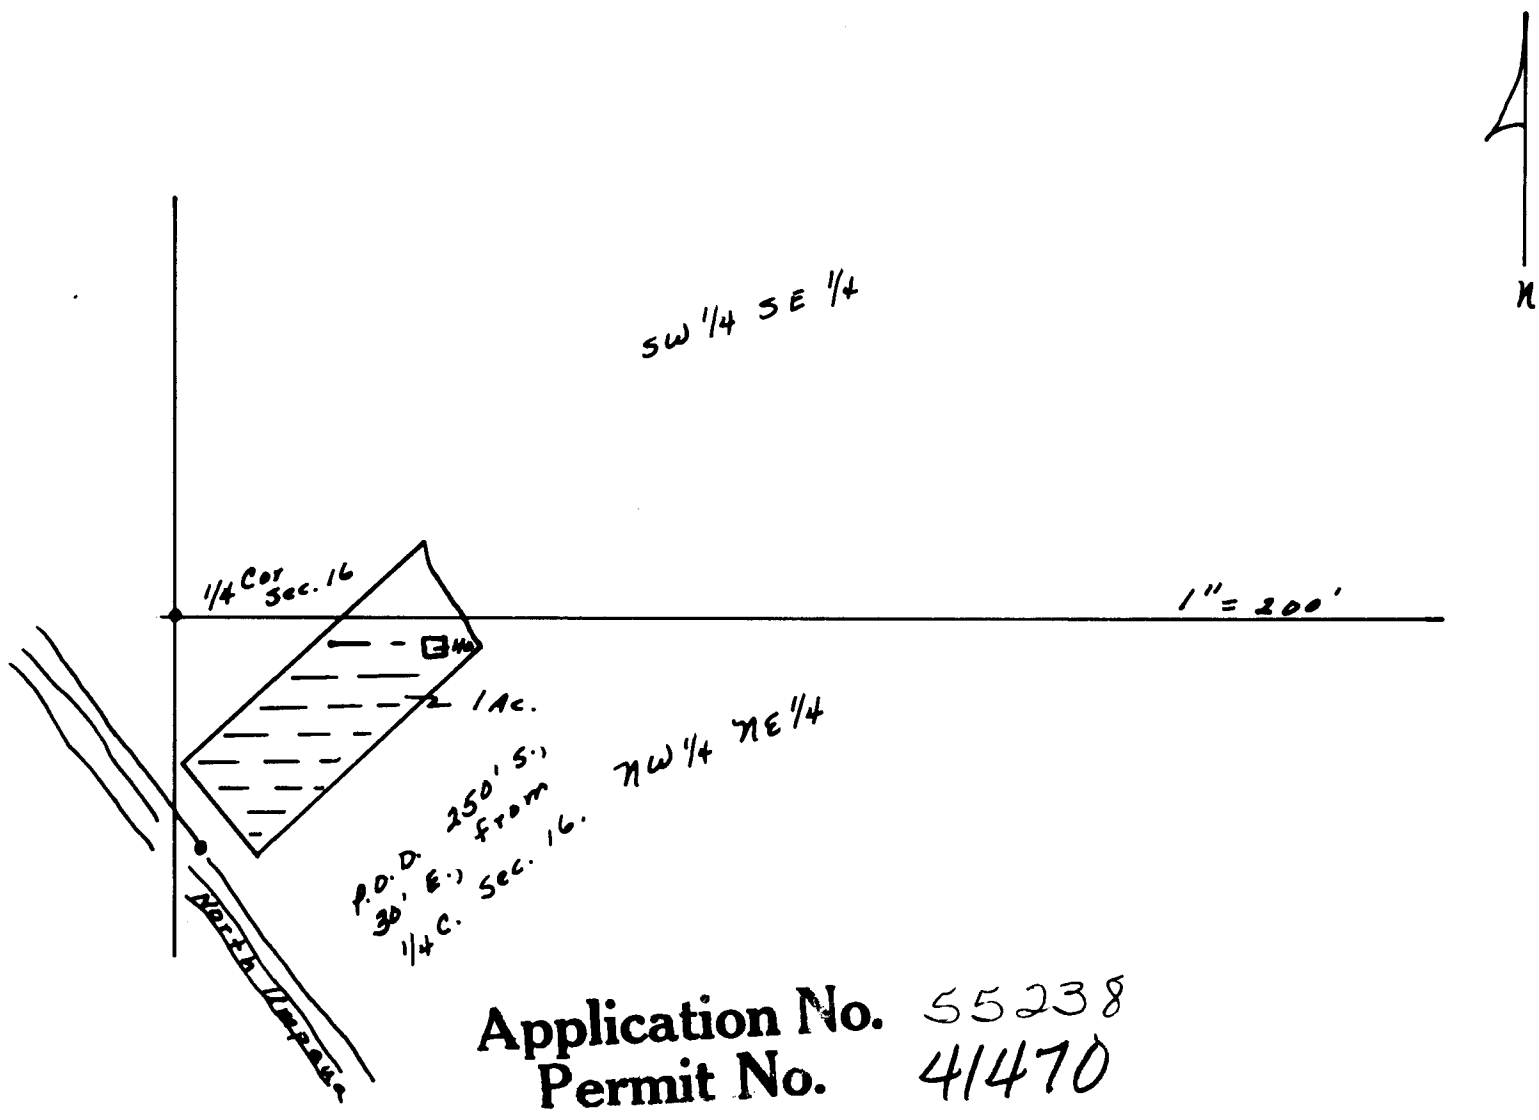

Application No. 55238  
Permit No. 41470

T26 S R5W Pt. S 1/2 SEC. 16

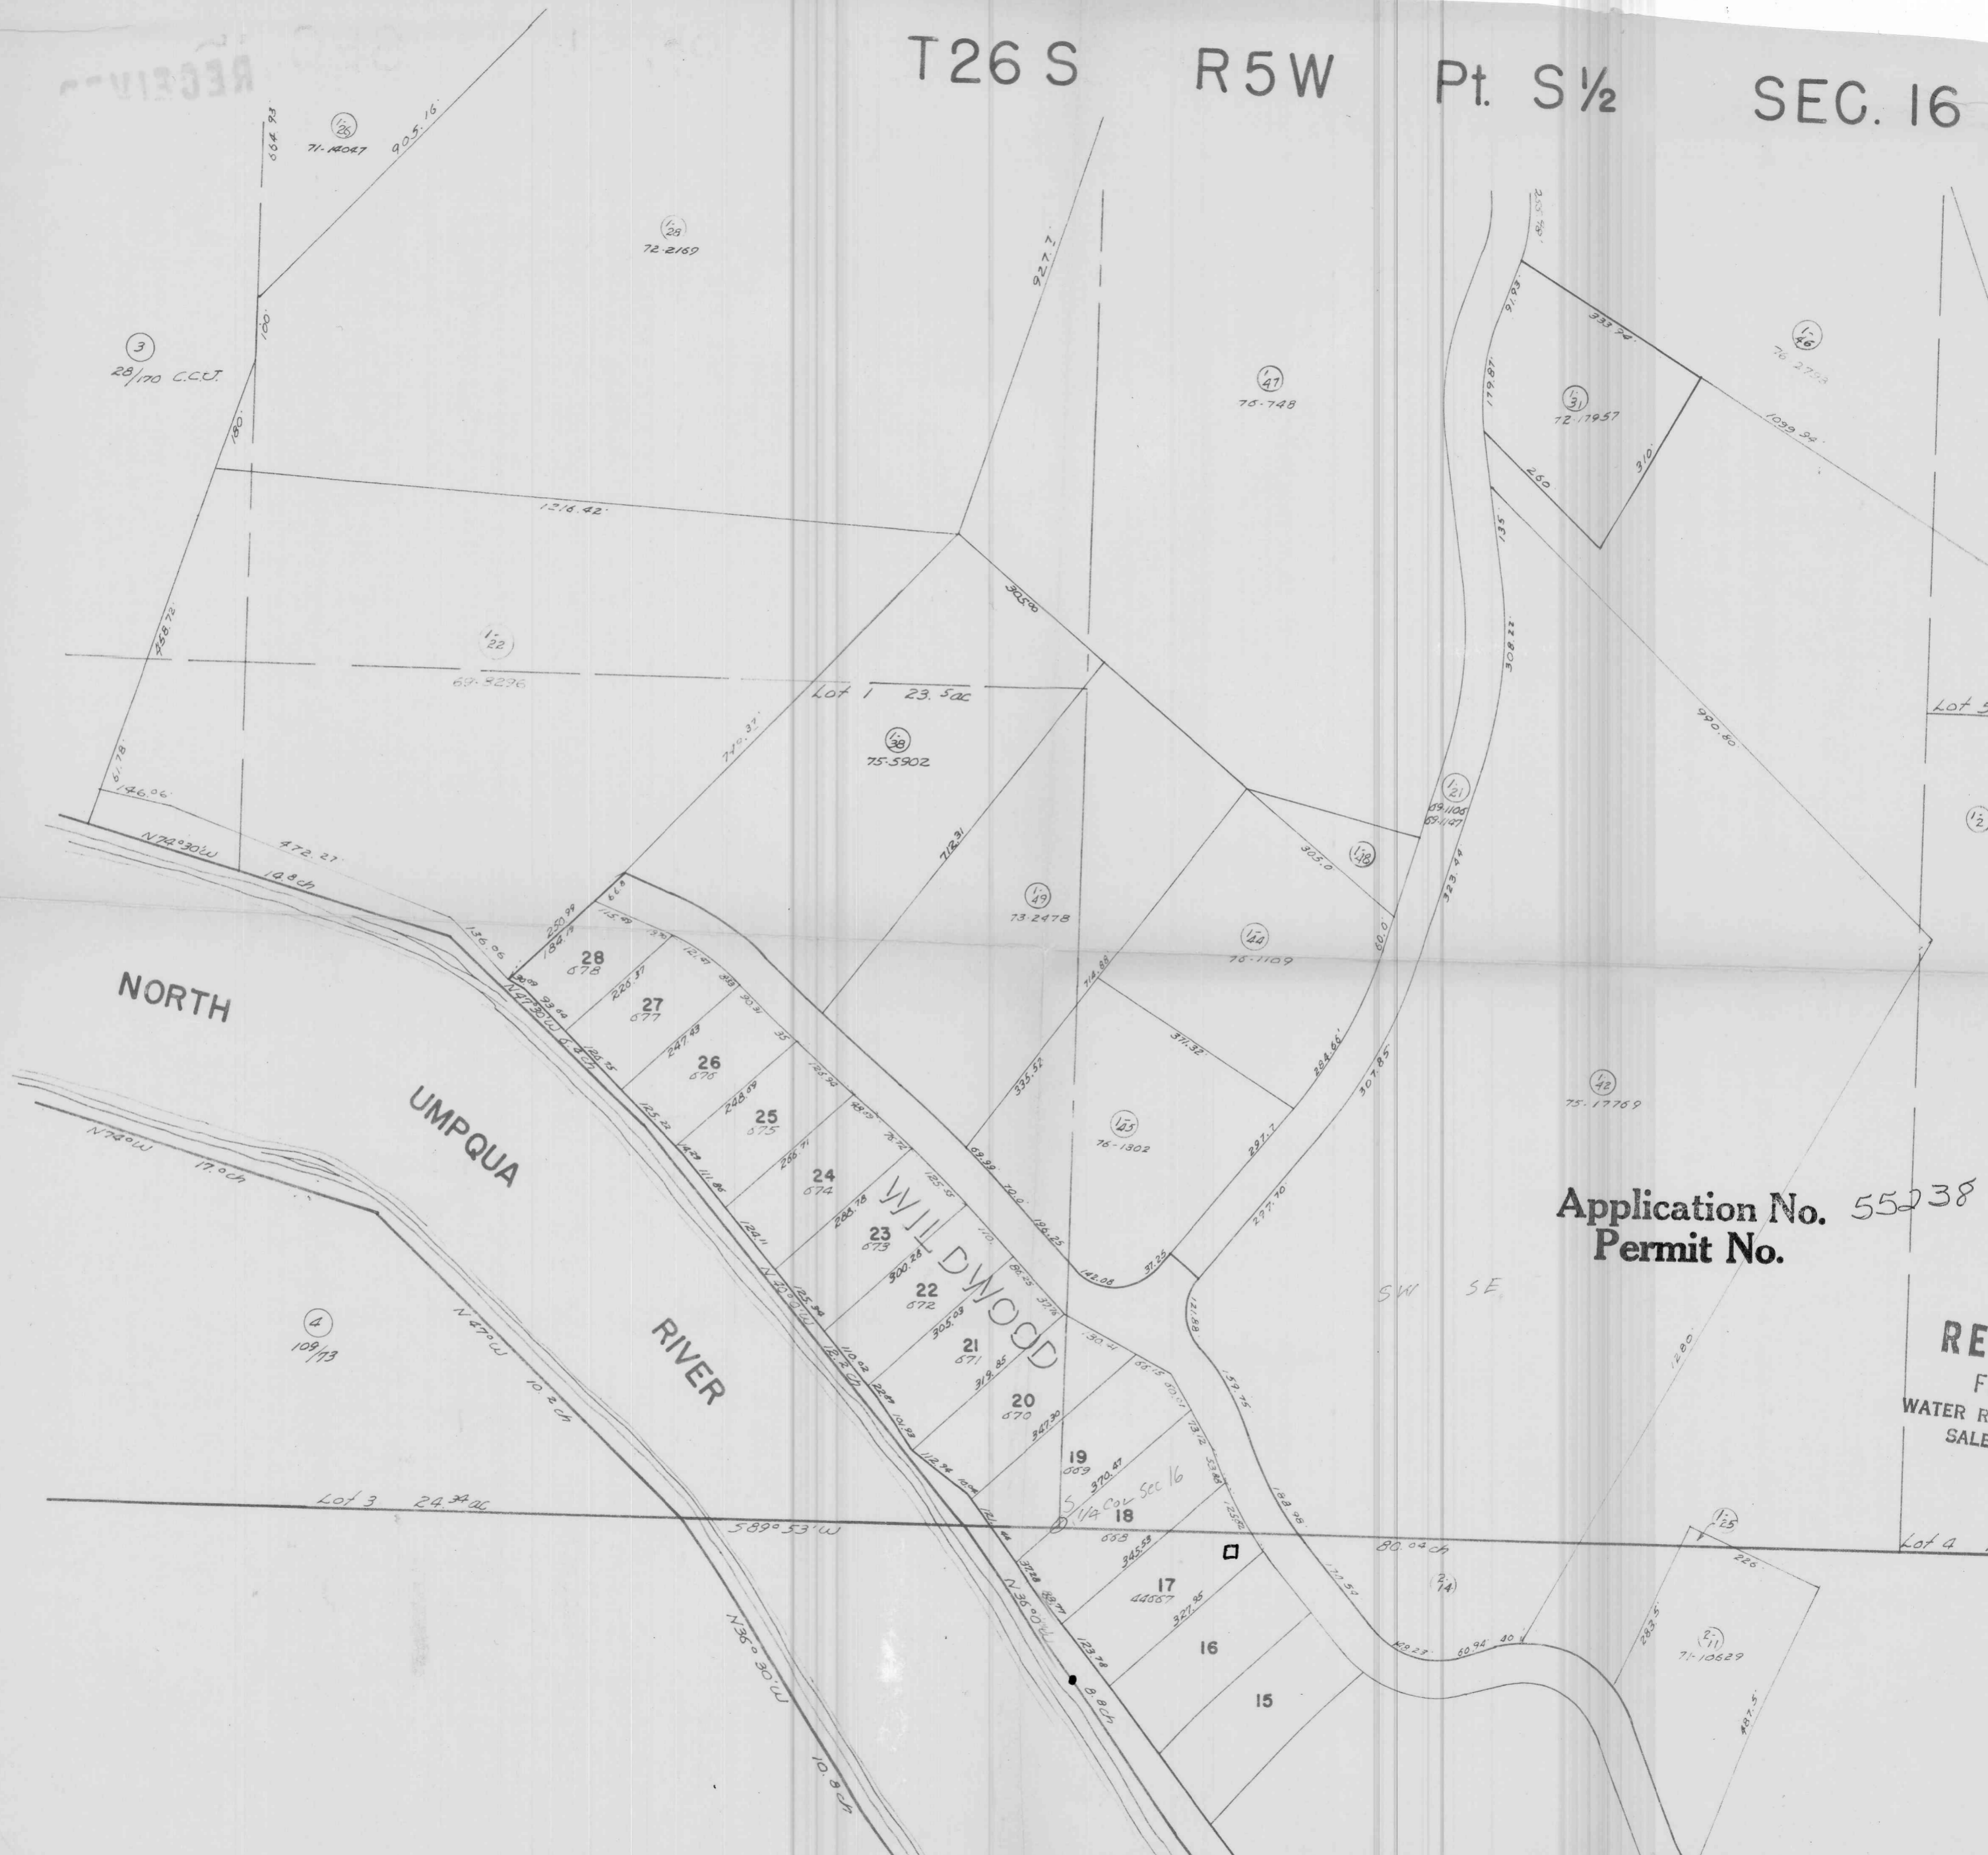

Application No. 55238  
Permit No.

RECEIVED  
FEB 1  
WATER RESOURCES  
SALEM, OR