


Permit: S 41518
Volume: 1
Strm: ROGUE R
Trib: PACIFIC OCEAN
Priority: 8/07/72

T.36 S., R.5 W., W.M.

RECEIVED

DEC 22 1981

WM. DIST. 14
GRANTS PASS, ORE

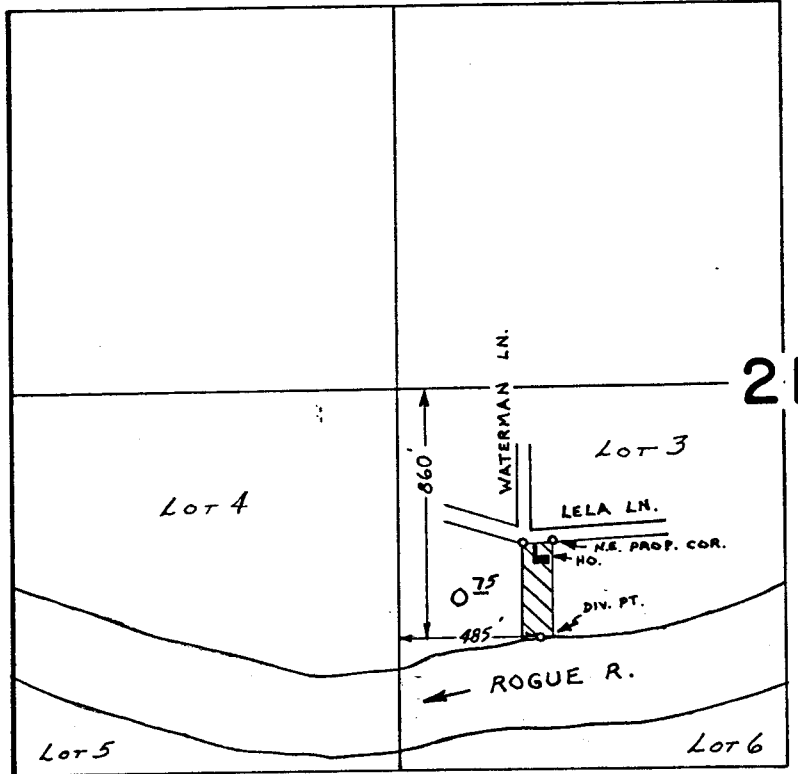

SCALE: 1" = 660 FT.

FINAL PROOF SURVEY
UNDER

Application No. 49561 Permit No. 41518
IN NAME OF

Cert. # 50439

ARMAND L. OLSON

Surveyed JUN. 22, 1978, by B. SUND

D.H.M.

P.T.S. - 1978 - 14 - A