


Application No. 55409
Permit No. 41599

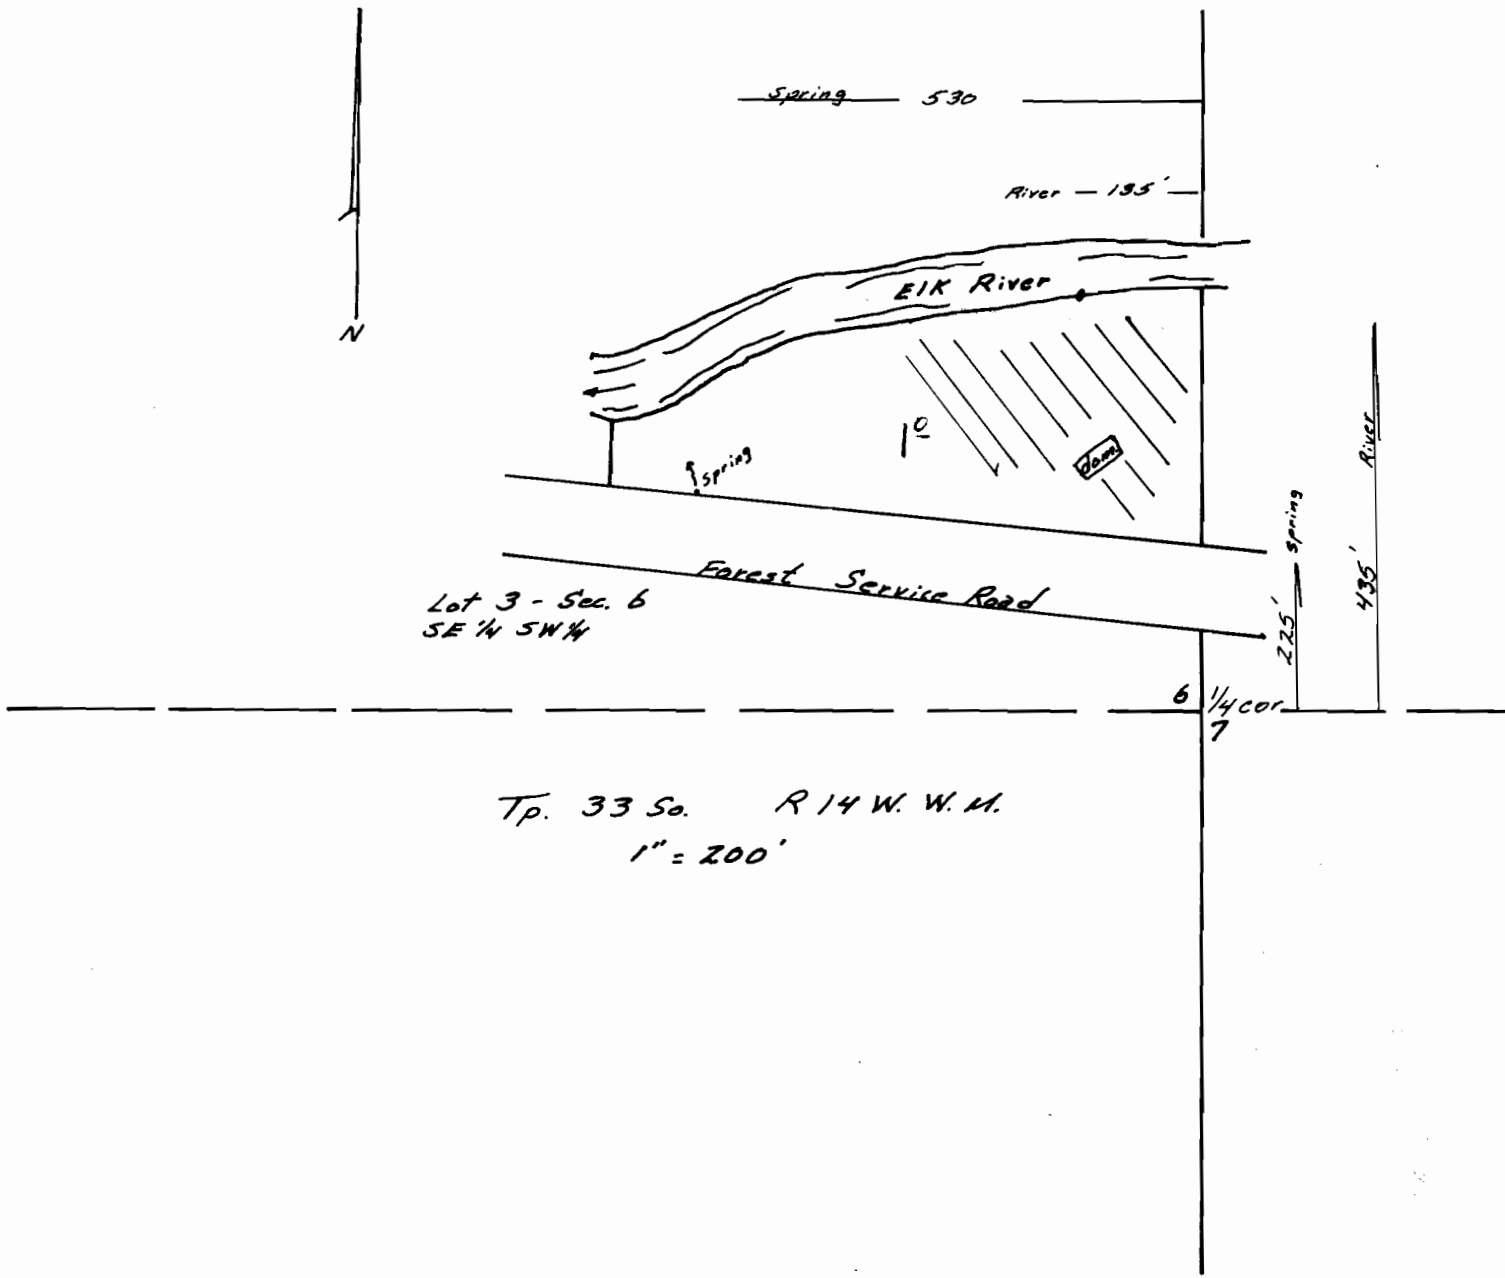

m.d.g.