


T.39S., R.8W., W.M.

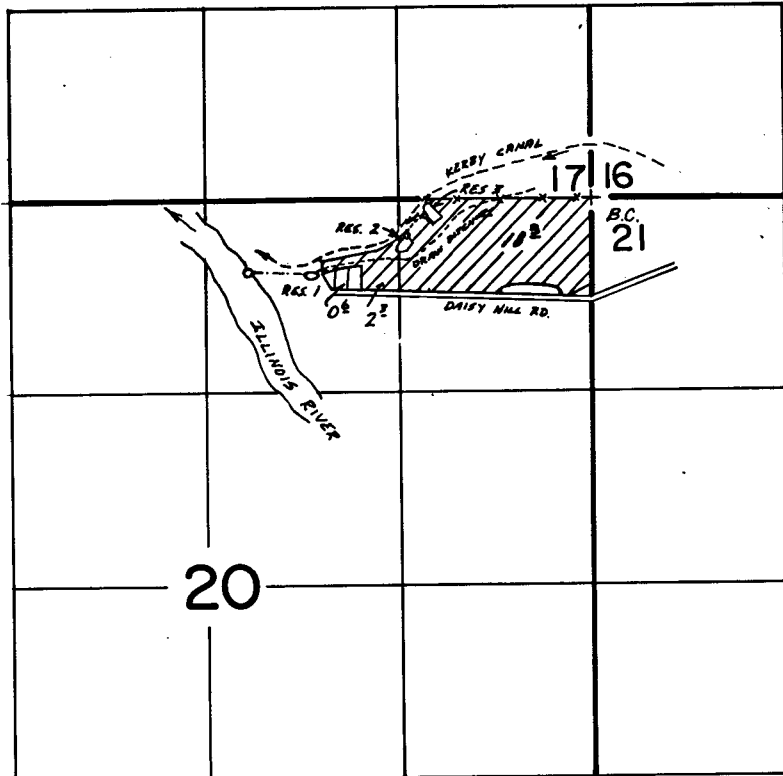

N  
RECEIVED

JUN 17 1987

RESERVOIR 1: 500' S & 1900' W from NE Cor. SEC. 20.  
 RESERVOIR 2: 300' S & 1300' W " " " " "  
 RESERVOIR 3: 100' S & 1100' W " " " " "

Scale 1" = 1320'

 SUPPLEMENTAL

**FINAL PROOF SURVEY**  
 UNDER

 PRIMARY

R-55659 R-6607

Application No. 54875. Permit No. 41647.....  
 IN NAME OF

.....DAVID E. ATKIN.....

Surveyed Aug. 24, 1982, by B.R. SUND.....