


T.33S.,R.5W.,W.M.

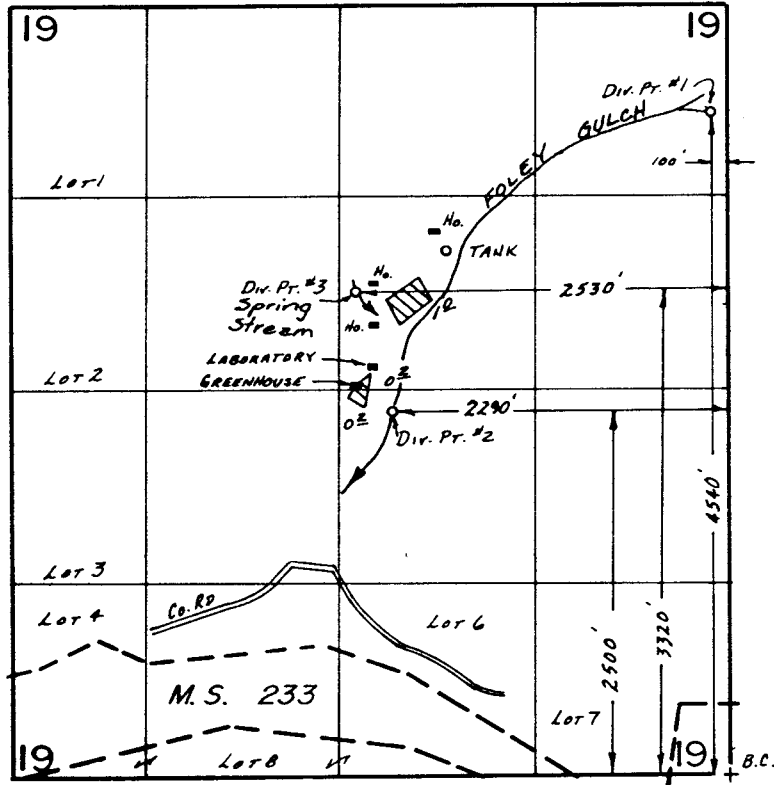

RECEIVED
MAR 03 1989
WM. DIST. 14
GRANT PASS, ORE.

SCALE: 1" = 1320'

FINAL PROOF SURVEY UNDER

Application No. 55578. Permit No. 41653.....
IN NAME OF

.....LICHEN.....

Surveyed Aug. 29. 19.84, by J.R. WOODROOF.

3/17/86
41033-179-129 R