


Permit: S 41676
Volume: 1
Strm: ROGUE R
Trib: PACIFIC OCEAN
Priority: 4/06/77

T. 35 S., R. 7 W., W. M.

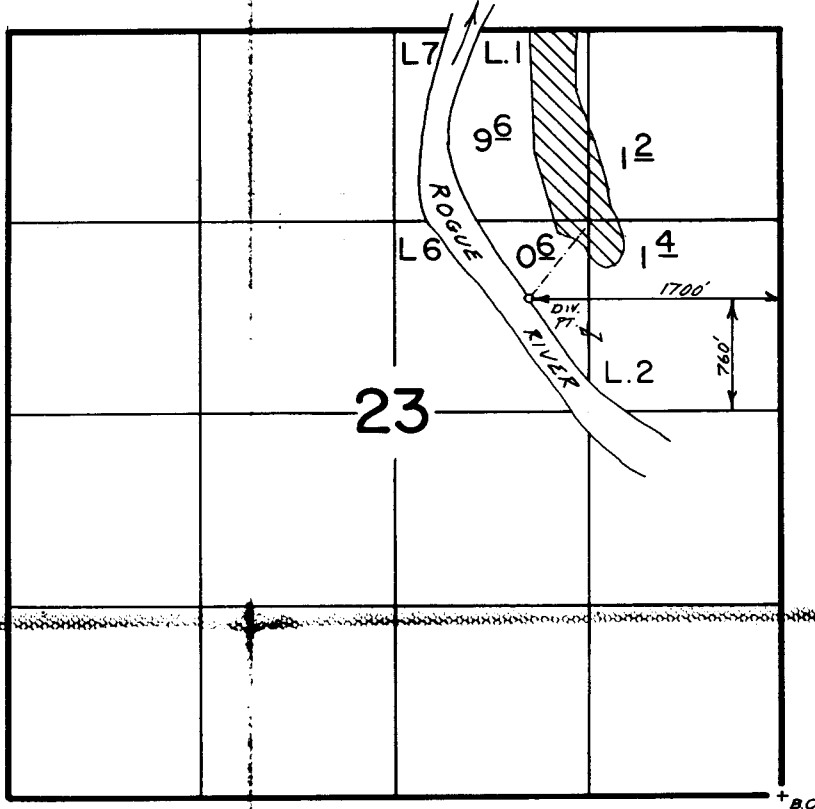

Scale: 1" = 1320'

MAY 6 1987

FINAL PROOF SURVEY UNDER

WM. DIST. 14
GRANTS PASS, ORE

Application No. ~~55626~~ Permit No. 41676.....
IN NAME OF

FREDERICK PONTE

Surveyed Oct. 26, 1987, by B.S. JAMES.....

41033-179-165R

bjj 11/88