


T. 37 S., R. 7 W., W. M.

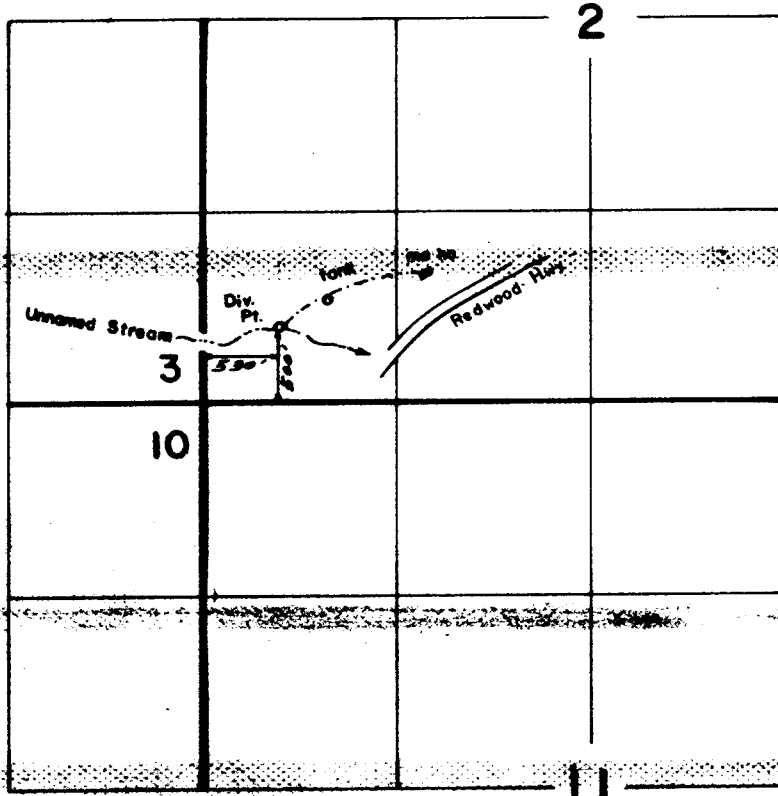

Scale: 1" = 1320'

RECEIVED

AUG 17 1988

**FINAL PROOF SURVEY**  
UNDER

Application No. 55642 Permit No. 41684....  
IN NAME OF

.....JEFFREY W. PETERSON.....

Surveyed JUL 28 1986, by B. S. JAMES.....

W.M. DIST. 14  
GRAND JURY FILE

01/33-125-1178 101