



T.38S., R.4W., W.M.

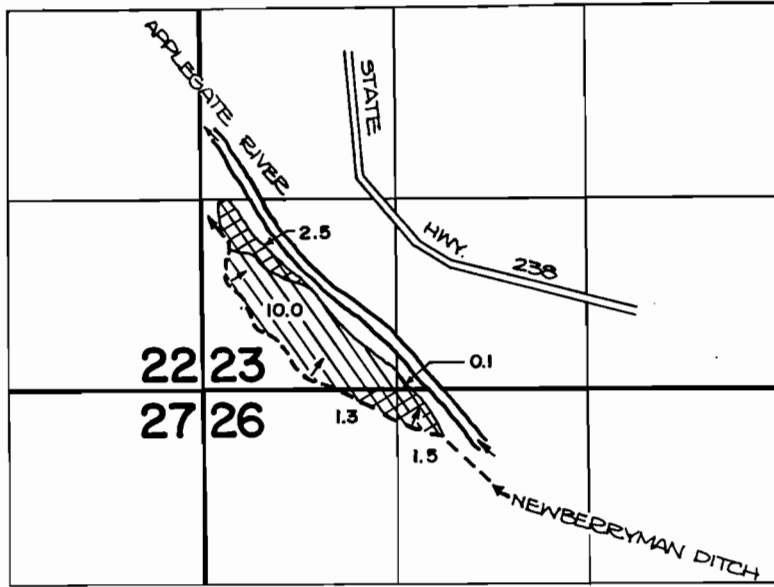

PERMIT 45962



PERMIT 41702

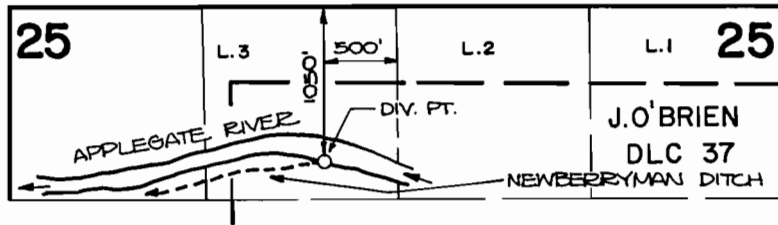

FINAL PROOF SURVEY UNDER

62133 45962
 Application No. ~~55669~~ Permit No. ~~41702~~....
 IN NAME OF

HENRY W. AND/OR JEANETTE R. HEAD

Surveyed April 6, 1982, by Bruce R. Sund.