


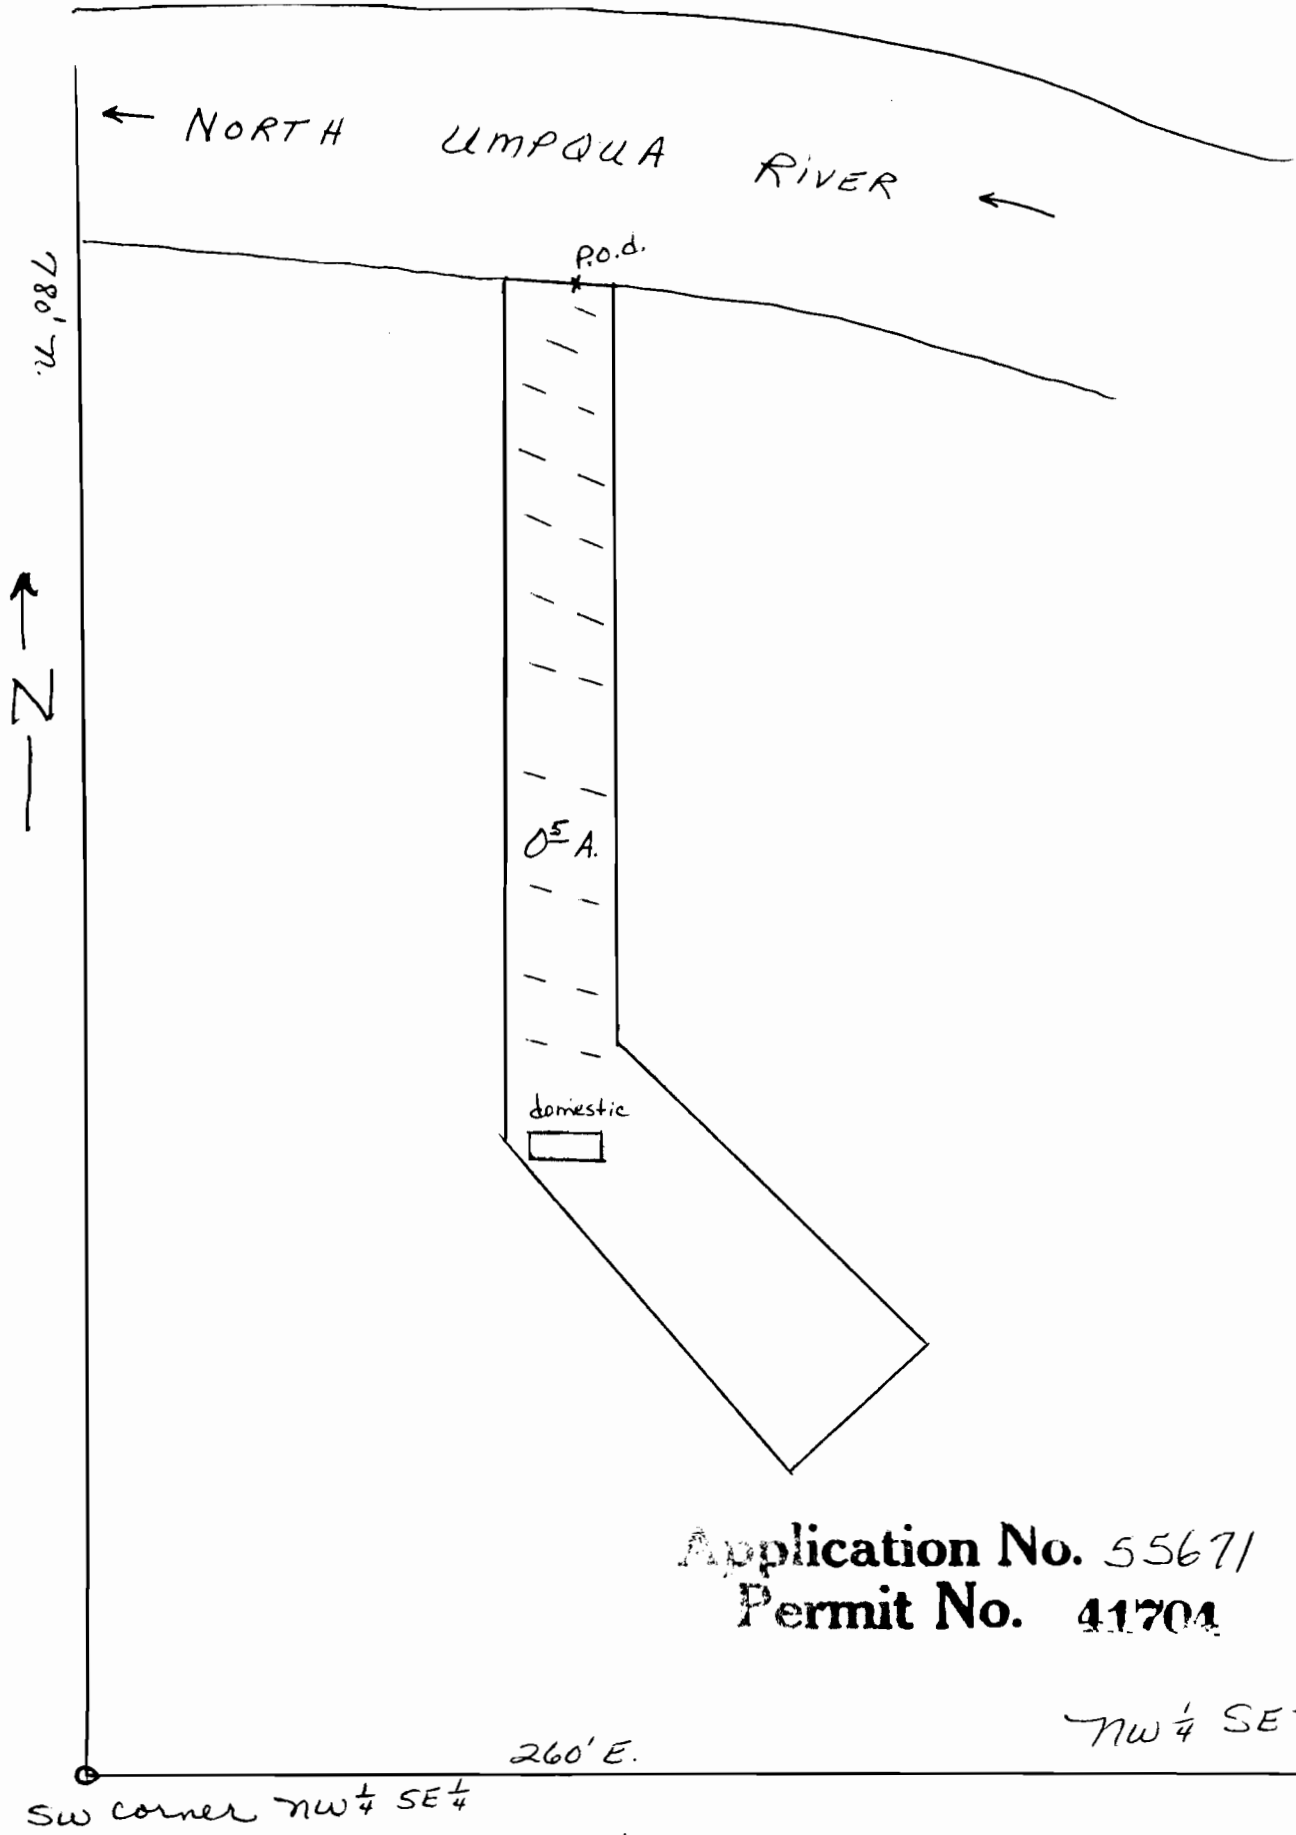

Application No. 55671
Permit No. 41704

SCALE 1" = 100'

D. P. CHAPMAN