


T.37S., R.7W., W.M.

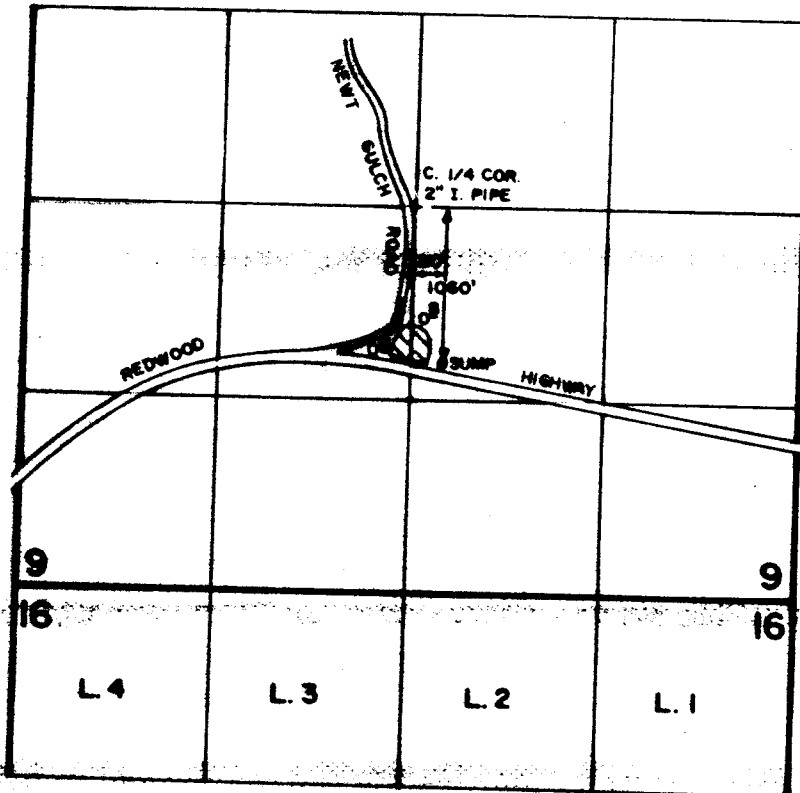

**FINAL PROOF SURVEY**  
UNDER

Application No. **55687** Permit No. **41715**  
IN NAME OF

**JAMES E. MALLOY**

Surveyed **OCT. 25** 19**83** by **B. S. JAMES**

SCALE: 4" = 1 MILE

RECEIVED

AUG 17 1988

LEGAL DIST. IN  

179-170L TWB