


Permit: S 41725
Volume: 1
Strm: ROGUE R
Trib: PACIFIC OCEAN
Priority: 4/18/77

T. 36S., R. 5 W., W. 1/4.

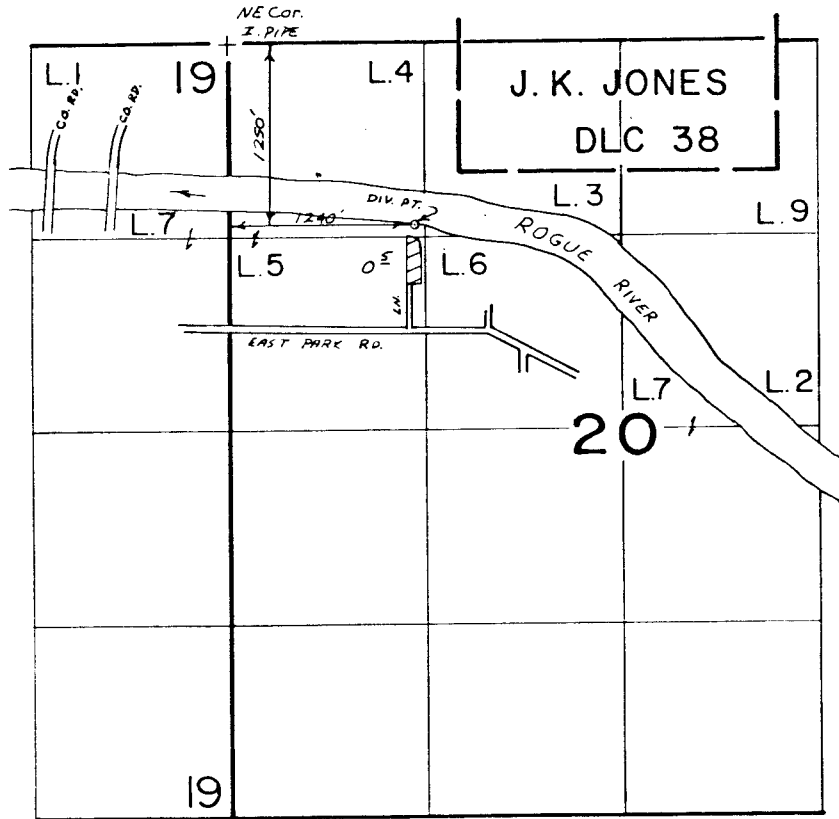

Scale 4" = 1 mile

FINAL PROOF SURVEY
UNDER

Application No. 55704 Permit No. 41725.....
IN NAME OF

.....
Surveyed Nov. 4, 1981, by Bruce R. Sund

B50-5-9

BSJ