


Section 18

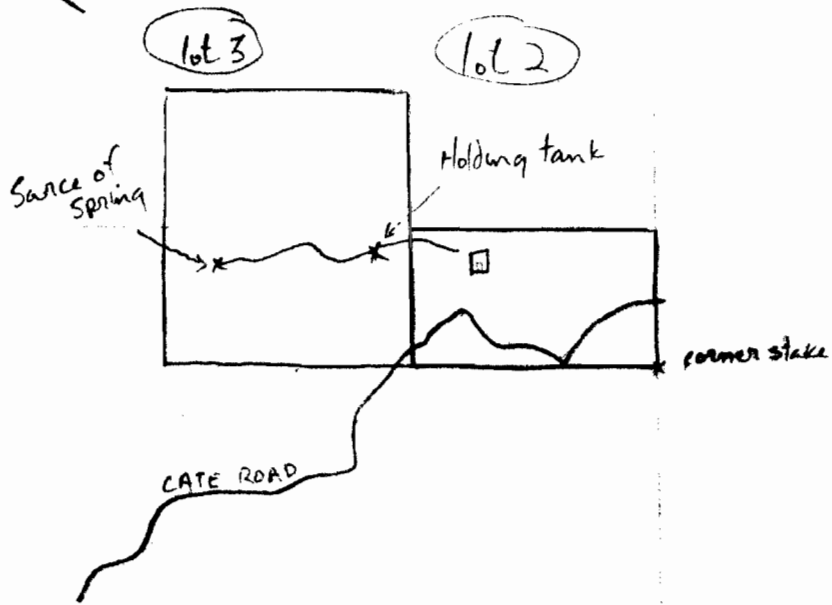

Application No. 55710
Permit No. 41728

$\frac{1}{12,000}$ Scale. 5" = 1 Mile