


T. 34S., R. 6W., W.M.

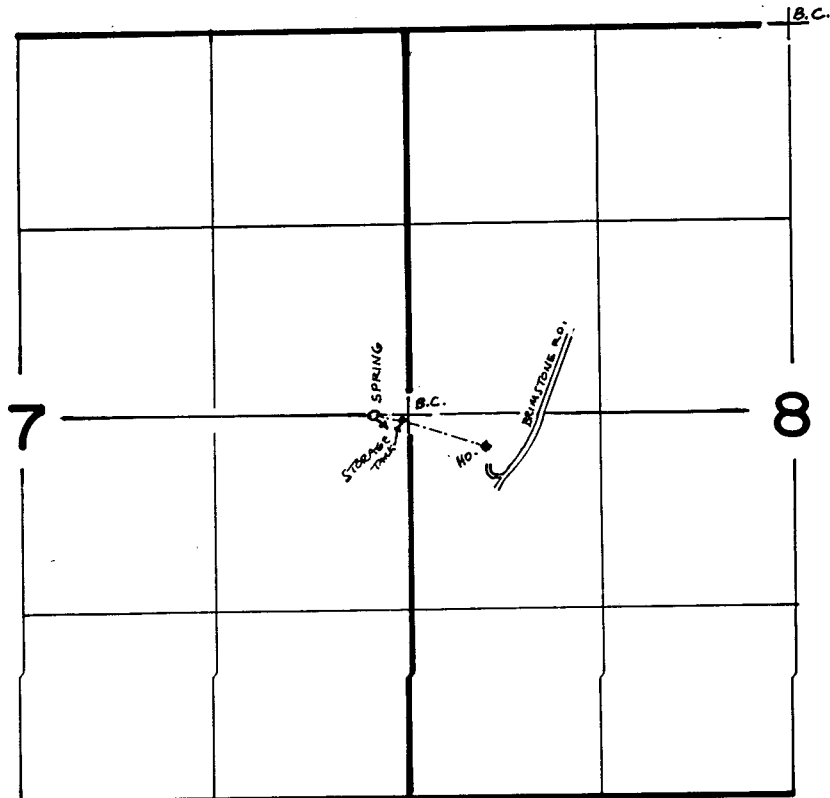

SPRING: 225' W. & 0' N. OF W. 1/4 CORNER SEC. 8

SCALE 1" = 1320"

RECEIVED

NOV 8 1988

W.F. DIST. 14
GRANTS PASS, ORE.

FINAL PROOF SURVEY

UNDER

Application No. 55715... Permit No. 41730.....
IN NAME OF

NORRIS HORN.....

Surveyed SEPT. 6. 1984., by J.R..W.O.Q.D.R.Q.F

41033-179-153L JAW