


Permit: S 41741
 Volume: 6B
 Strm: A SPR>PANTHER GU
 Trib: E FK WILLIAMS CR
 Priority: 4/21/77

T.39S., R.5W., W.M.

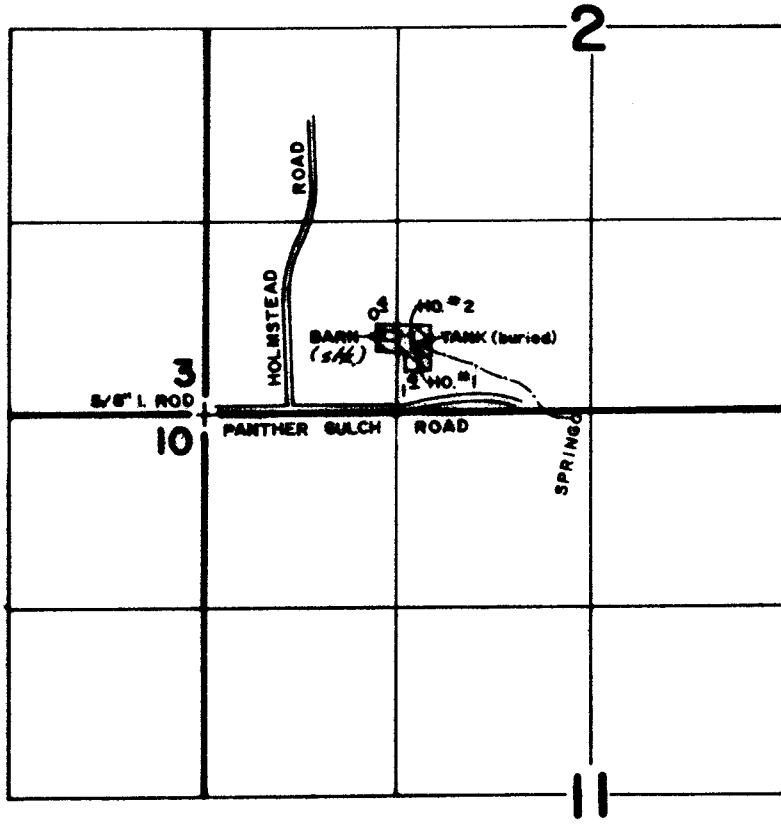

SPRINGS: 50' S. & 100' W. from S. 1/4 COR. SEC. 2

RECEIVED

AUG 23 1989

WEL LIST 14
 COUNTY PARK INC

**FINAL PROOF SURVEY
 UNDER**

Application No. **55731** Permit No. **41741**
 IN NAME OF

JEANINE BUCKLEY

Surveyed **AUG. 11** 19**83**, by **B. SUZIE JAMES**

SCALE: 4" = 1 MILE

179-107R TWB