


T. 40S., R. 8W., W.M.

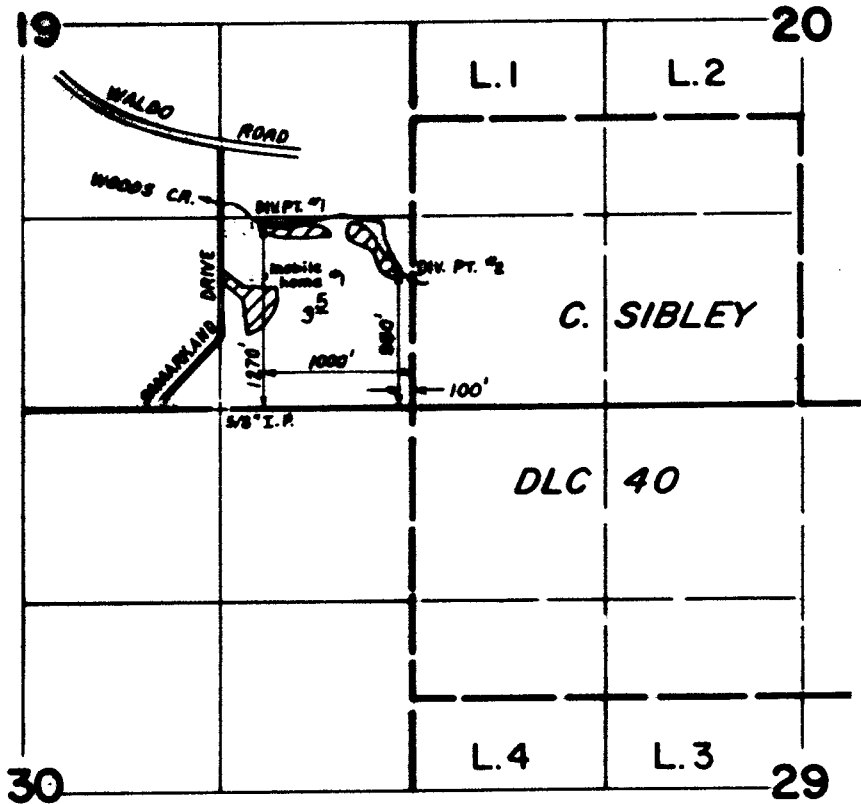

Scale: 4" = 1 mile

RECEIVED

DEC 14 1988

FINAL PROOF SURVEY
UNDER

Application No. **55766** Permit No. **41758**
IN NAME OF

G. EDWARD MICHELS

Surveyed **MAR. 26 19. 84** by **B. S. JAMES**