SECTION 11 T1N R4W W.M.

WASHINGTON COUNTY OREGON

SCALE 1"=400'

IN 4 11

RECEIVED
MAY 2 1977
WATER RESOURCES DEPT.
SALEM, OREGON

Application No. 55799
Permit No. 41777

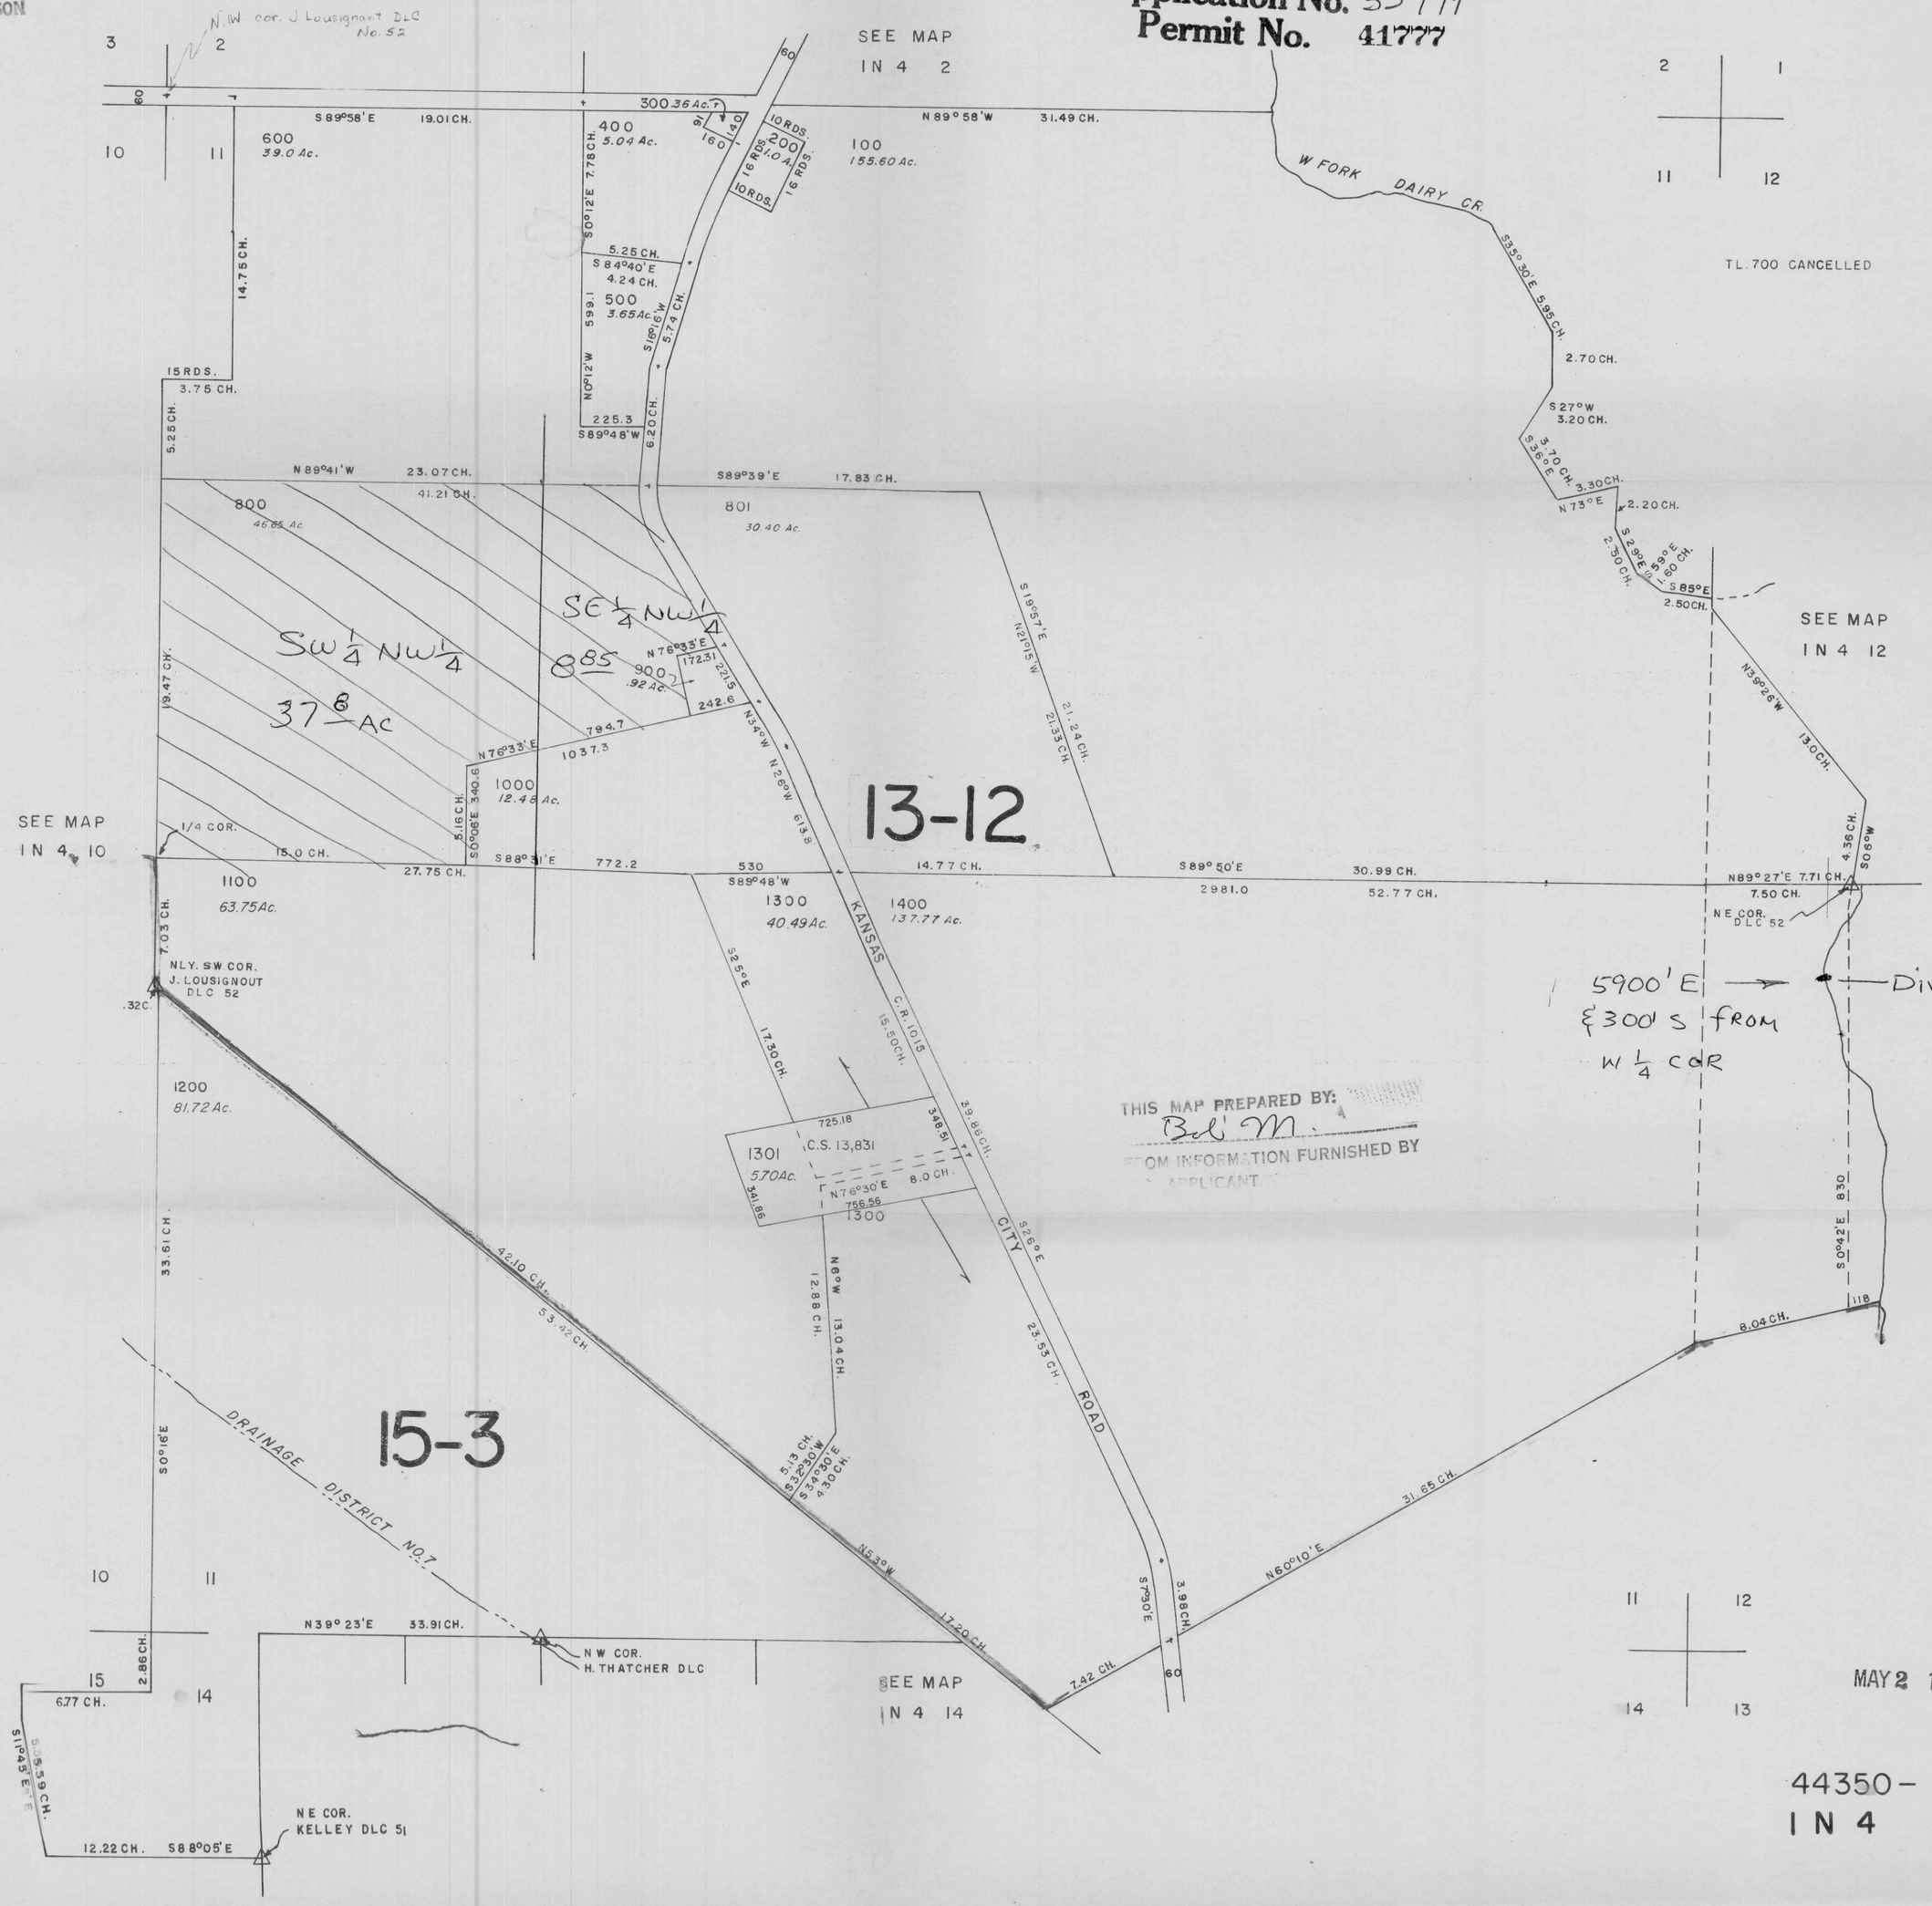

MAY 2 1977

44350-
IN 4 11