

141-77

RECEIVED


Application No. 55372

APR 18 1977

Permit No. 41803

WATER RESOURCES DEPT.  
SALEM, OREGON

T. 8 S., R. 4 W., W. M.

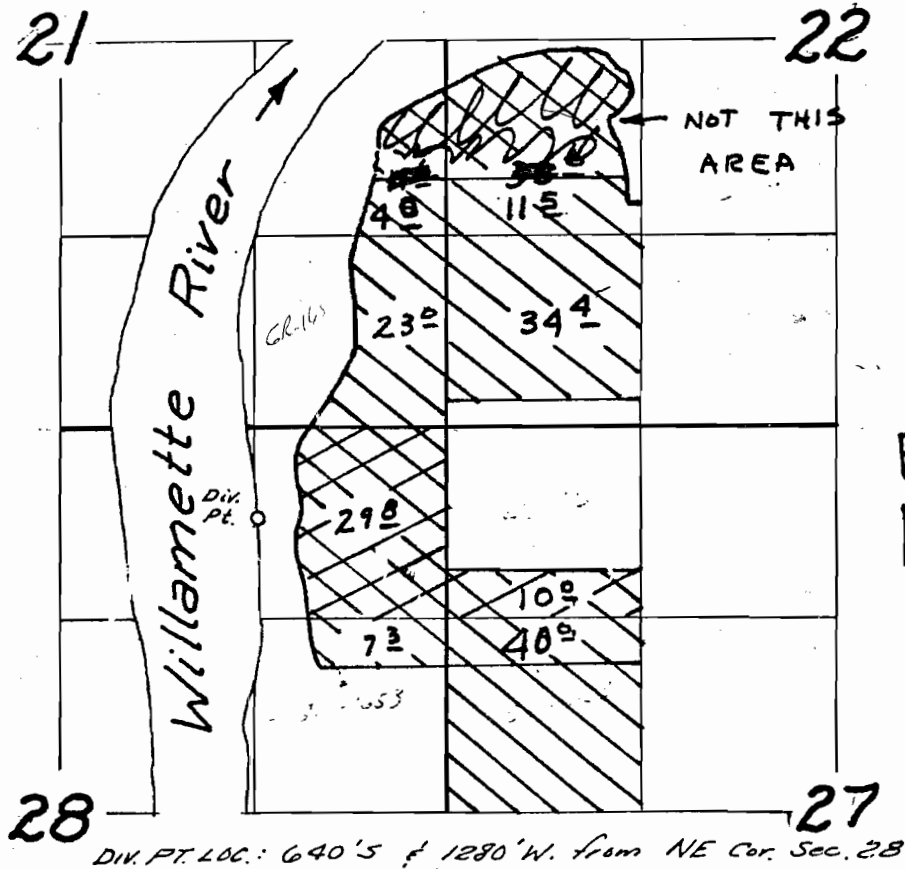

WATER RESOURCES DEPT  
117B CHEMEKETA ST. N.E  
SALEM, ORE