


T. 37S., R. 8W., W.M.

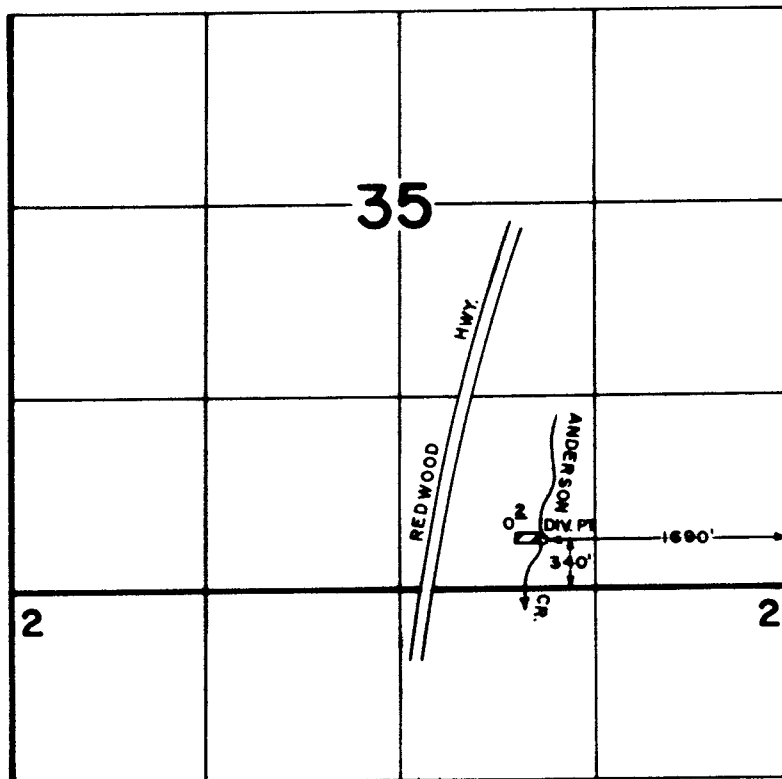

FINAL PROOF SURVEY
UNDER

MAR 28 1989

Application No. **55465** Permit No. **41829**
IN NAME OF

MR. & MRS. ANTONIO HOLGUIN

Surveyed **OCT. 26** 19. **83**, by **B. S. JAMES**

SCALE: 4" = 1 MILE

179-195L

TWB