

BOOK 19

SECTION 14
JOSEPH

Permit: S 41840
Volume: 6B
Strm: ROCK CR/SPRING CR
Trib: WILLIAMS CR
Priority: 3/18/77


RECEIVED
FEB 8 1978

WM. DIST. 14
GRANTS PASS, ORE


1" = 400'

57-0-17

SEE MAP 39 5 11

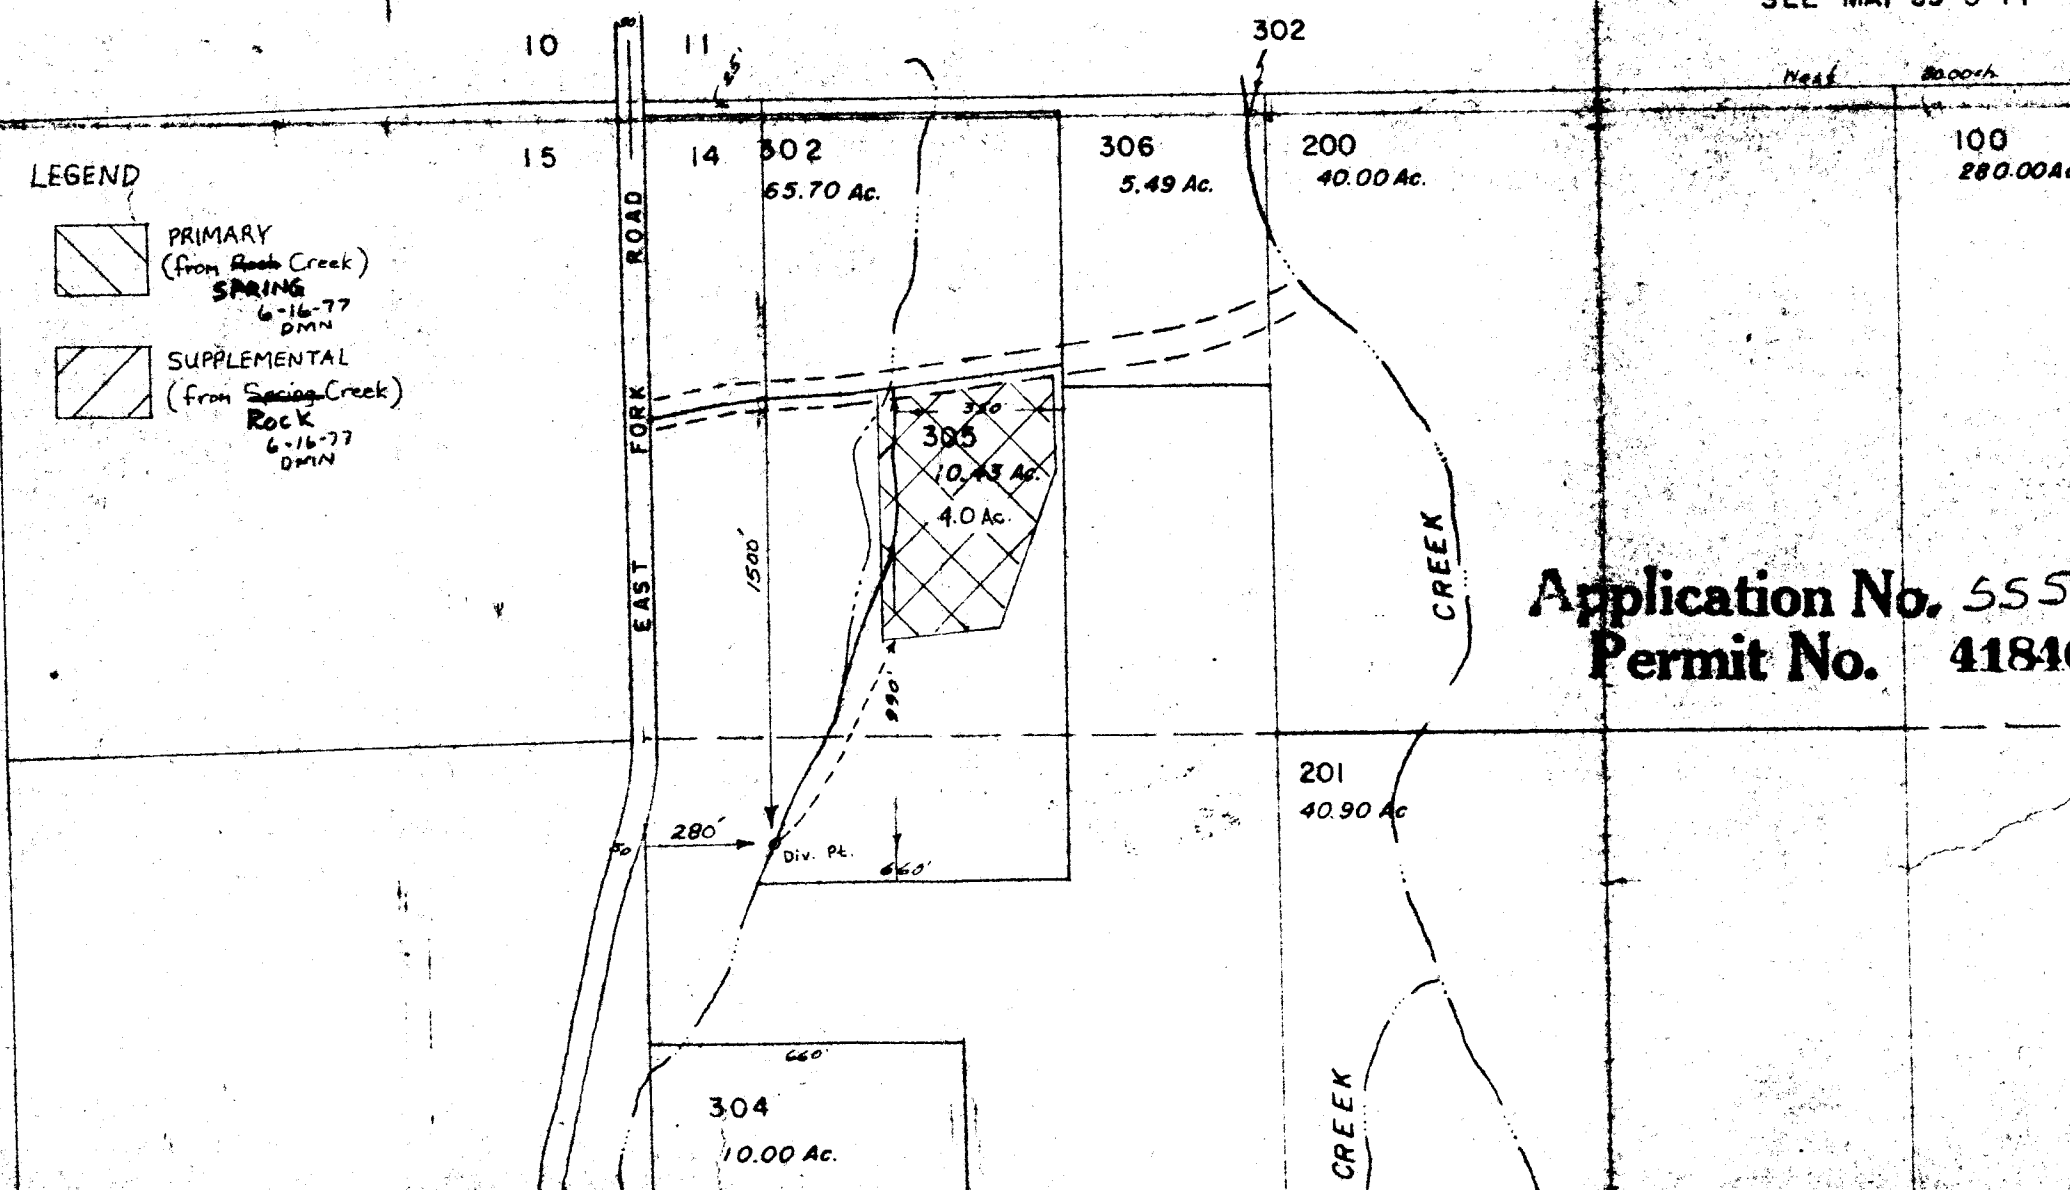

Application No. 55509
Permit No. 41840

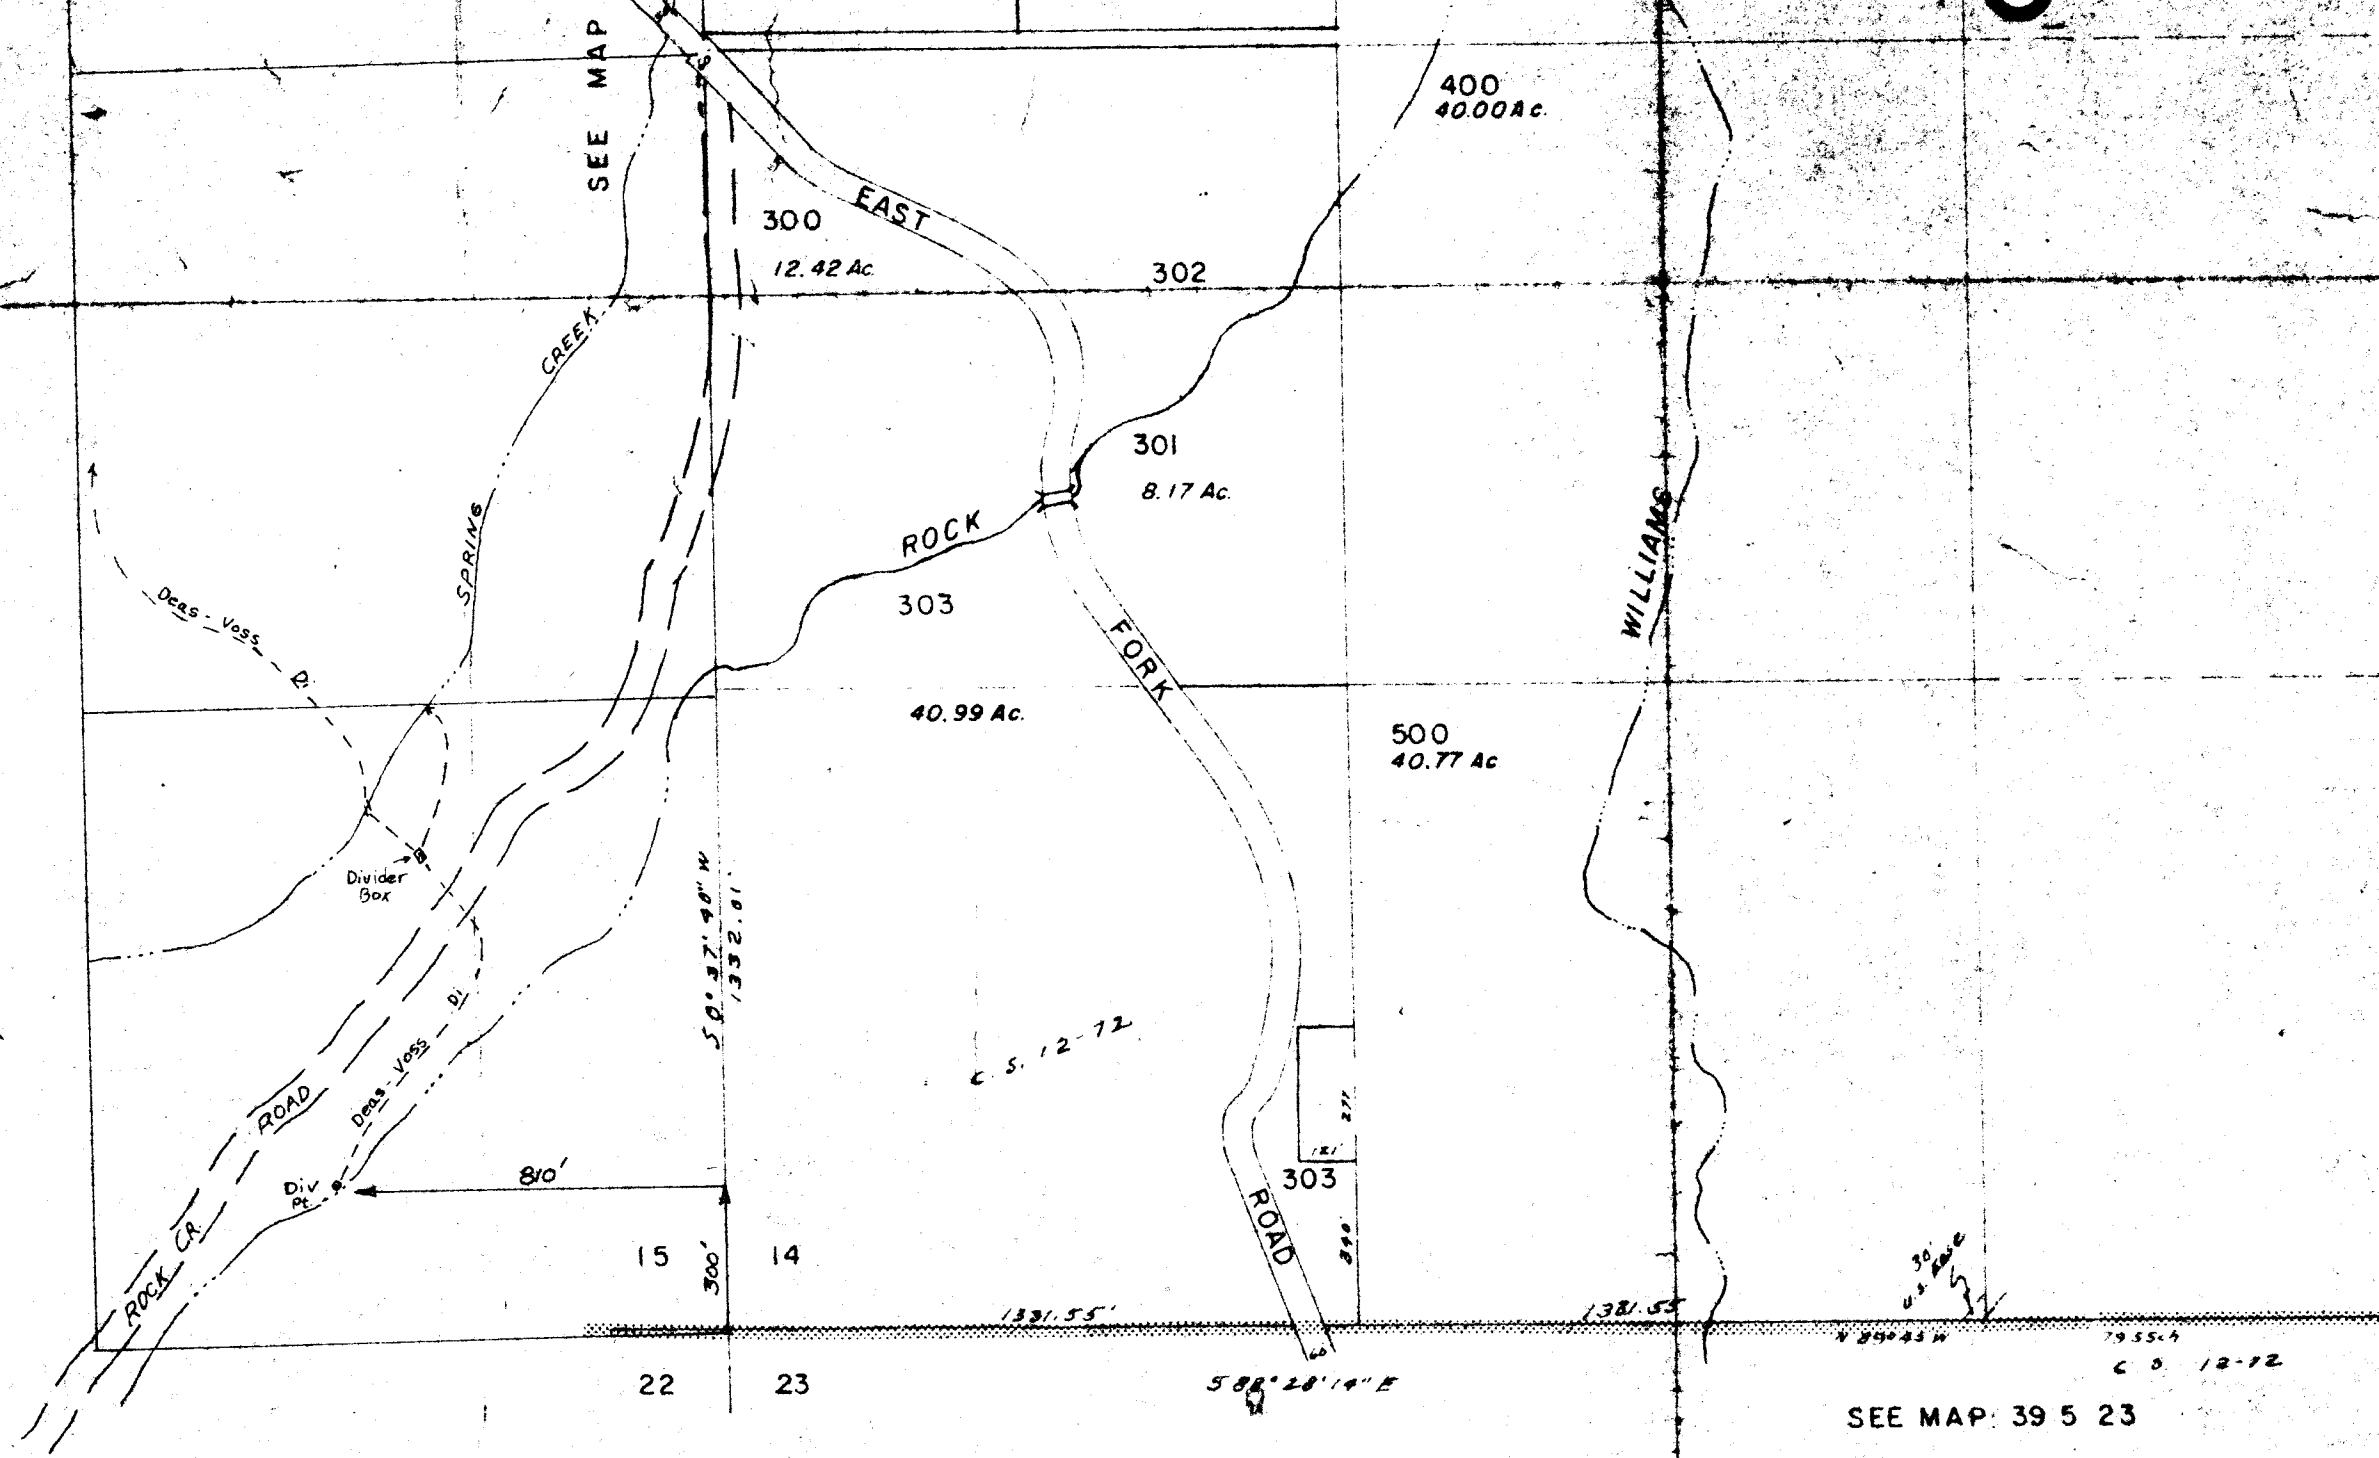

SEE MAP: 39 5 23