


T. 34S., R. 8W., W.M.

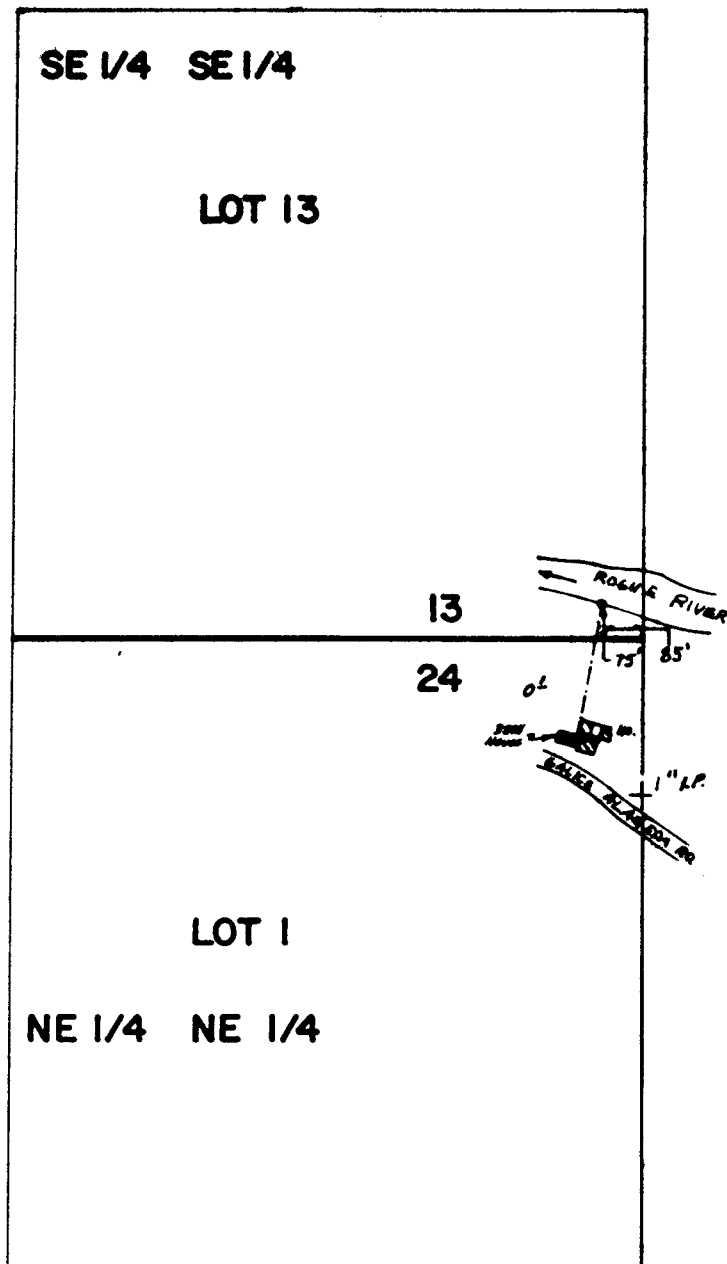

SCALE : 1" = 400'

FINAL PROOF SURVEY
UNDER

MAR 1 1989

Application No. **55099** Permit No. **41866**
IN NAME OF

SUNDANCE EXPEDITIONS, INC.

Surveyed **JUNE 27 1984** by **B. S. JAMES**

PTS. - 1984 - 13A JRW