


T. 34 S., R. 6 W., W.M.

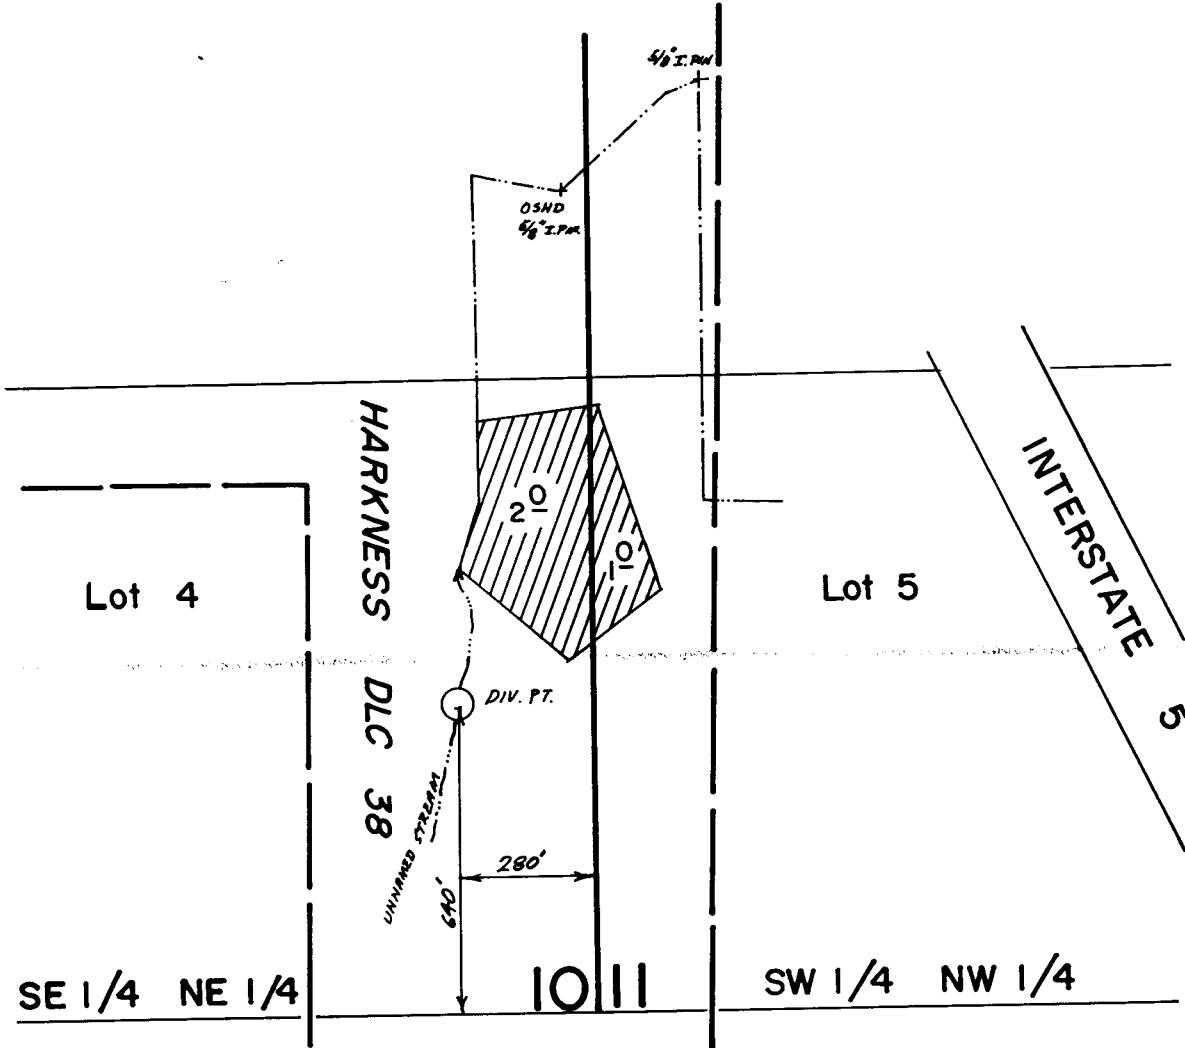

Scale 1"=400'

**FINAL PROOF SURVEY**  
UNDER

RECEIVED

MAR 18 1991

WM. DIST. 14  
GRANTS PASS, ORE.

Application No. 55822. Permit No. 41884.....  
IN NAME OF

RACECRAFTERS INC.....

Surveyed Sept. 18, 1984, by J.R. WOODROOF

PTS-1984-13A

651