


THIS MAP PREPARED BY: Bob Man  
FROM INFORMATION FURNISHED BY THE APPLICANT.

T.13S., R.28E., W.M.

Application No. 55875  
Permit No. 41911

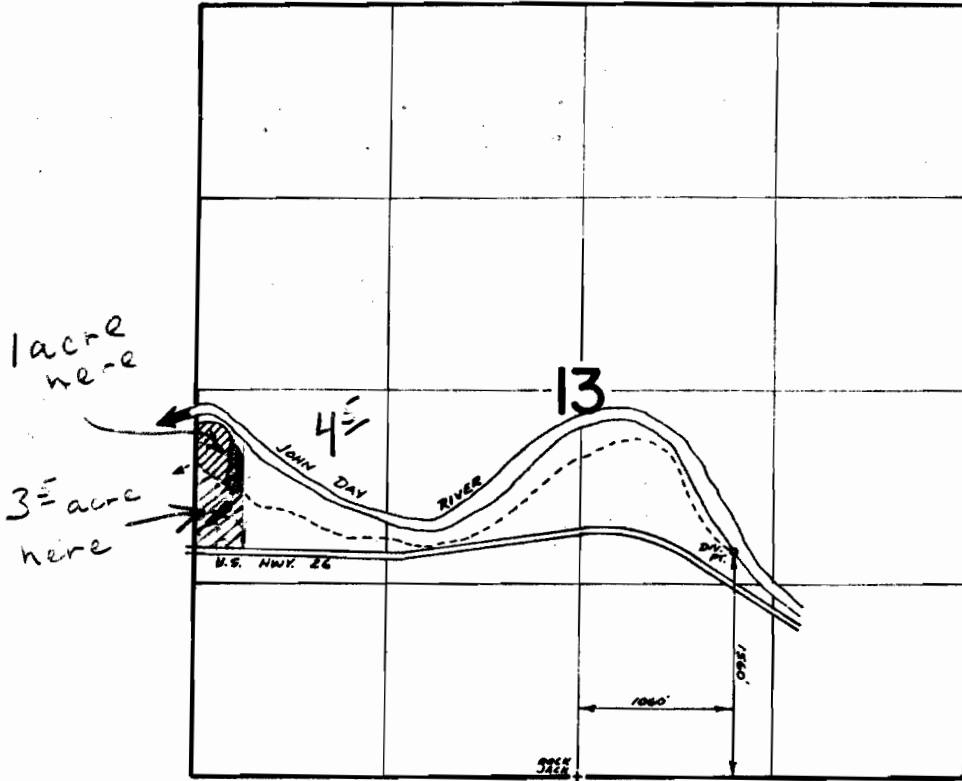

WATER RIGHTS PERMIT  
SALES DIVISION

Application Map  
~~FINAL PROOF SURVEY~~  
UNDER  
For  
Eugene and Mandy Lippert  
Application No. ~~4330~~ Permit No. ~~5018~~  
IN NAME OF  
EUGENE AND MANDY LIPPERT  
Surveyed June 21, 1975, by D. Norby