


NW 1/4 SECTION 34, T. 13 S. R. 10 W. W.M.  
LINCOLN COUNTY

13 10 34 B

1" = 200'

SEE MAP 13 10 27

CODES-300-331  
322-323

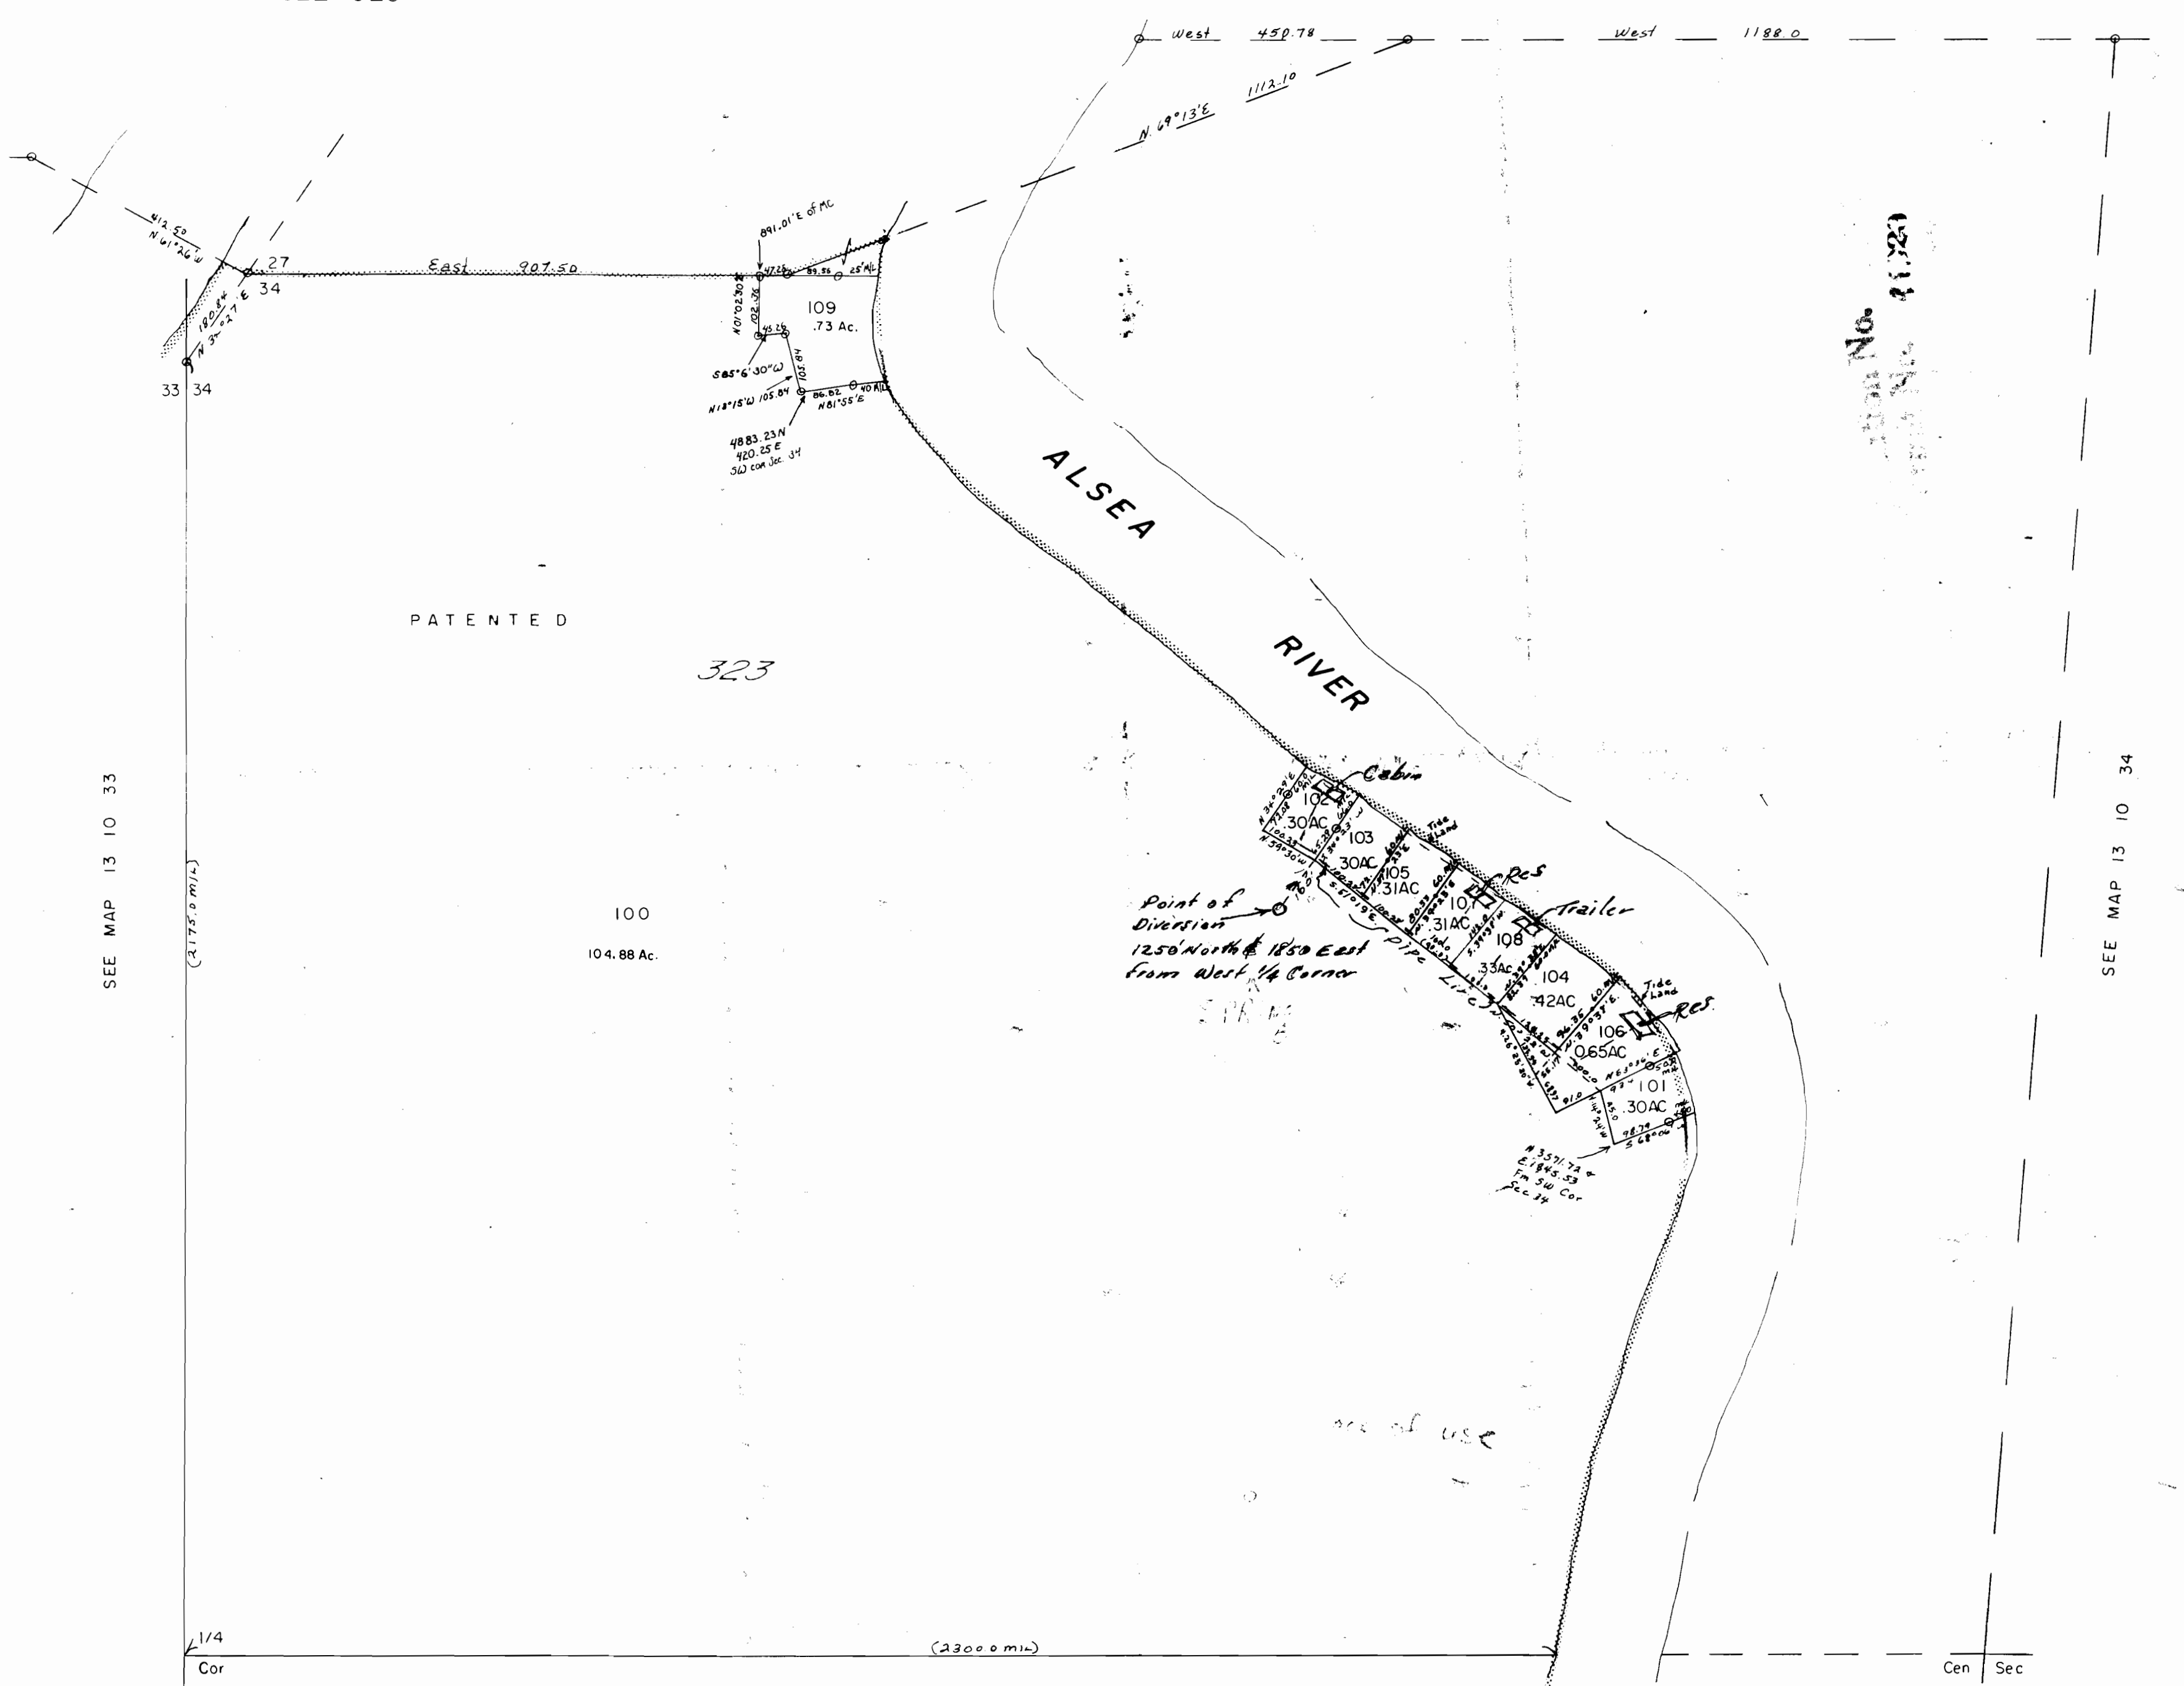

No. 41320

SEE MAP 13 10 33

SEE MAP 13 10 34

SEE MAP 13 10 34 C

As of  
6-7-76

13 10 34 B