


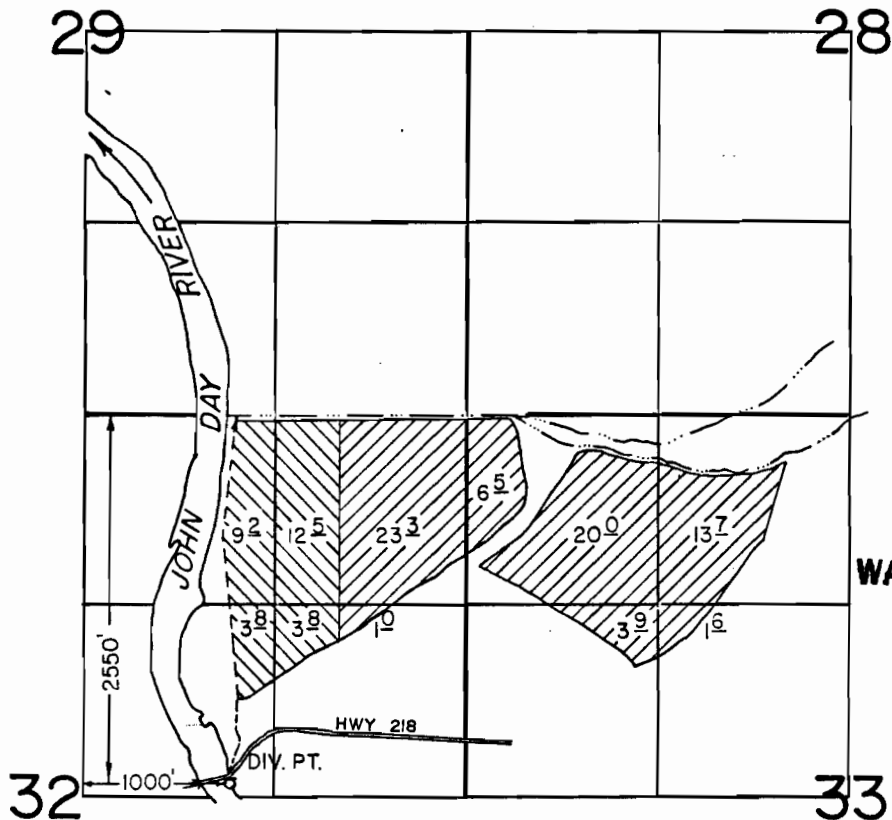

T. 7S., R. 19E., W.M.



RECEIVED
JUL 1 1983
WATER RESOURCES DEPT.
SALEM, OREGON

FINAL PROOF SURVEY

UNDER

 TR. 3686
 PER. 41937

TR. 3686
Application No. 55986..... Permit No. 41937.....
IN NAME OF

.....BRUCE & GLORIA A. LIGHTHART.....

Surveyed JUNE.26.... 19.80., by S.C. BROWN.....