Application No. 55988
Permit No. 41938

Section 23 T.19S. R.12 W.W.M.
LANE COUNTY
1" = 880
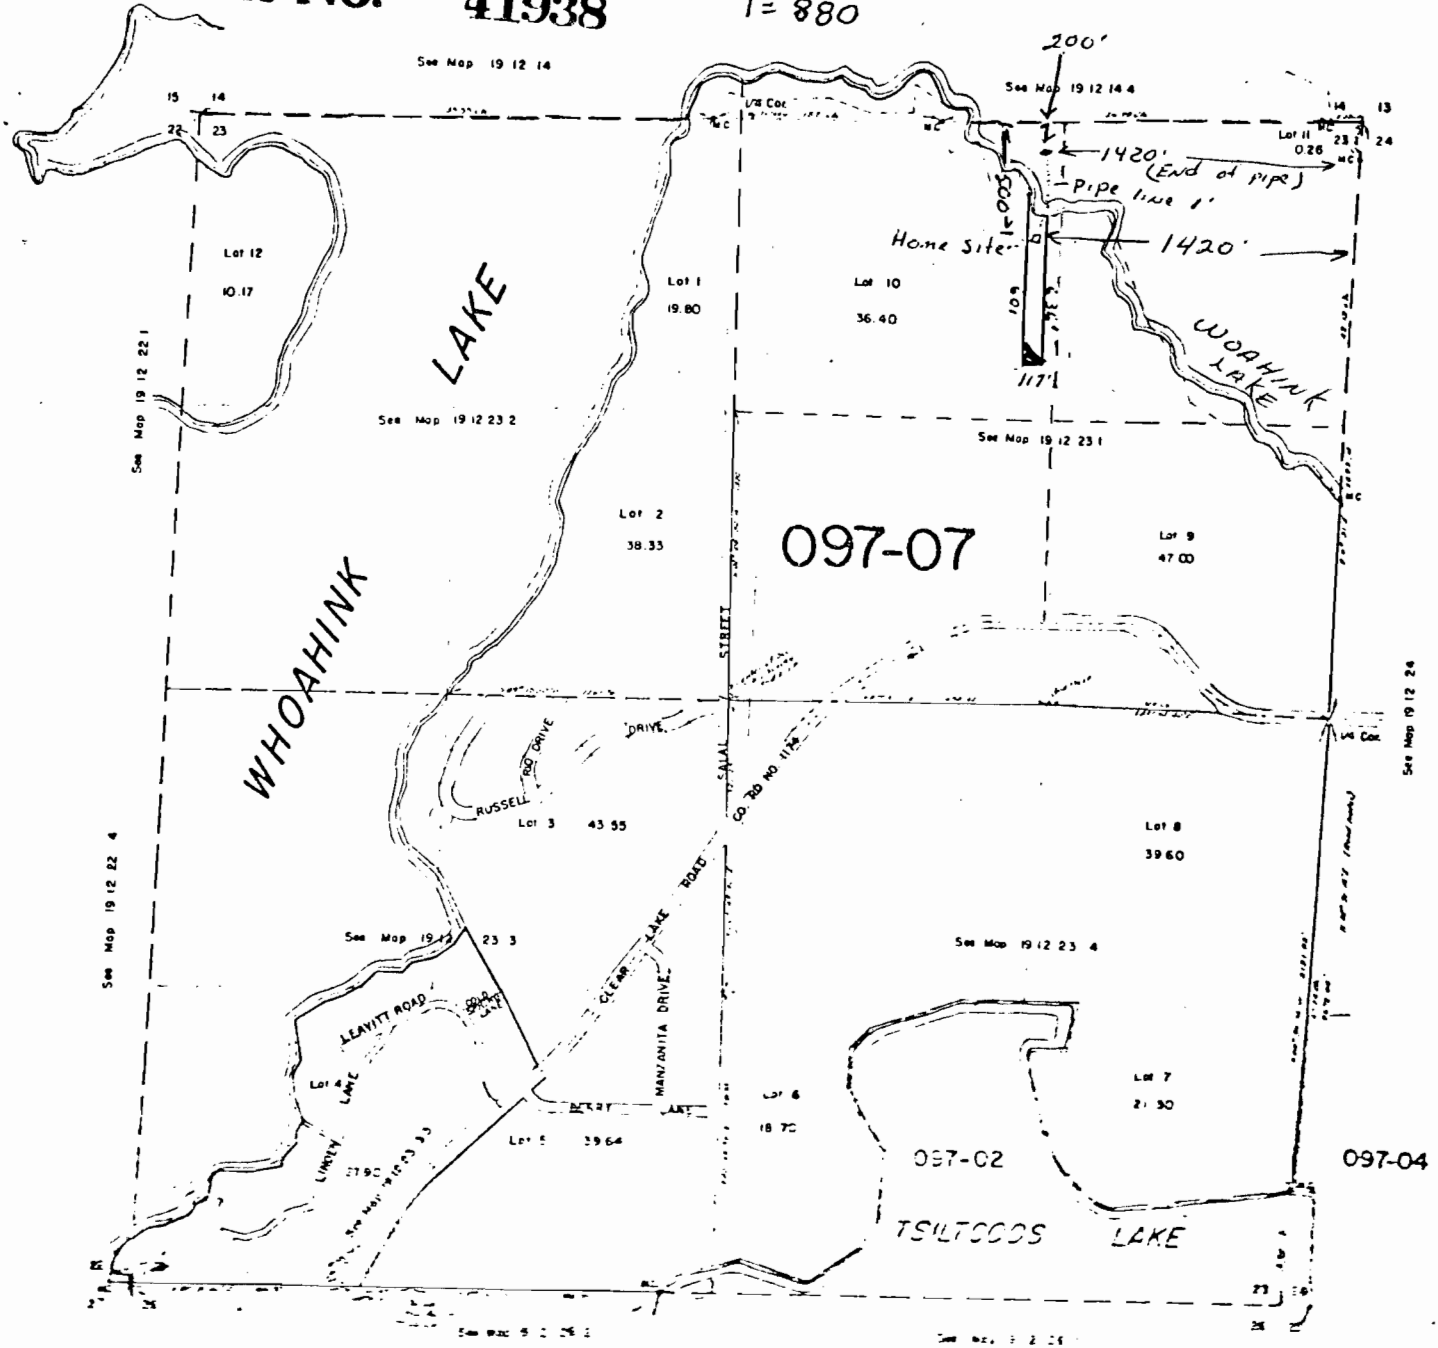
19 12 23
8 INDEX