


Scale 1" = 400'

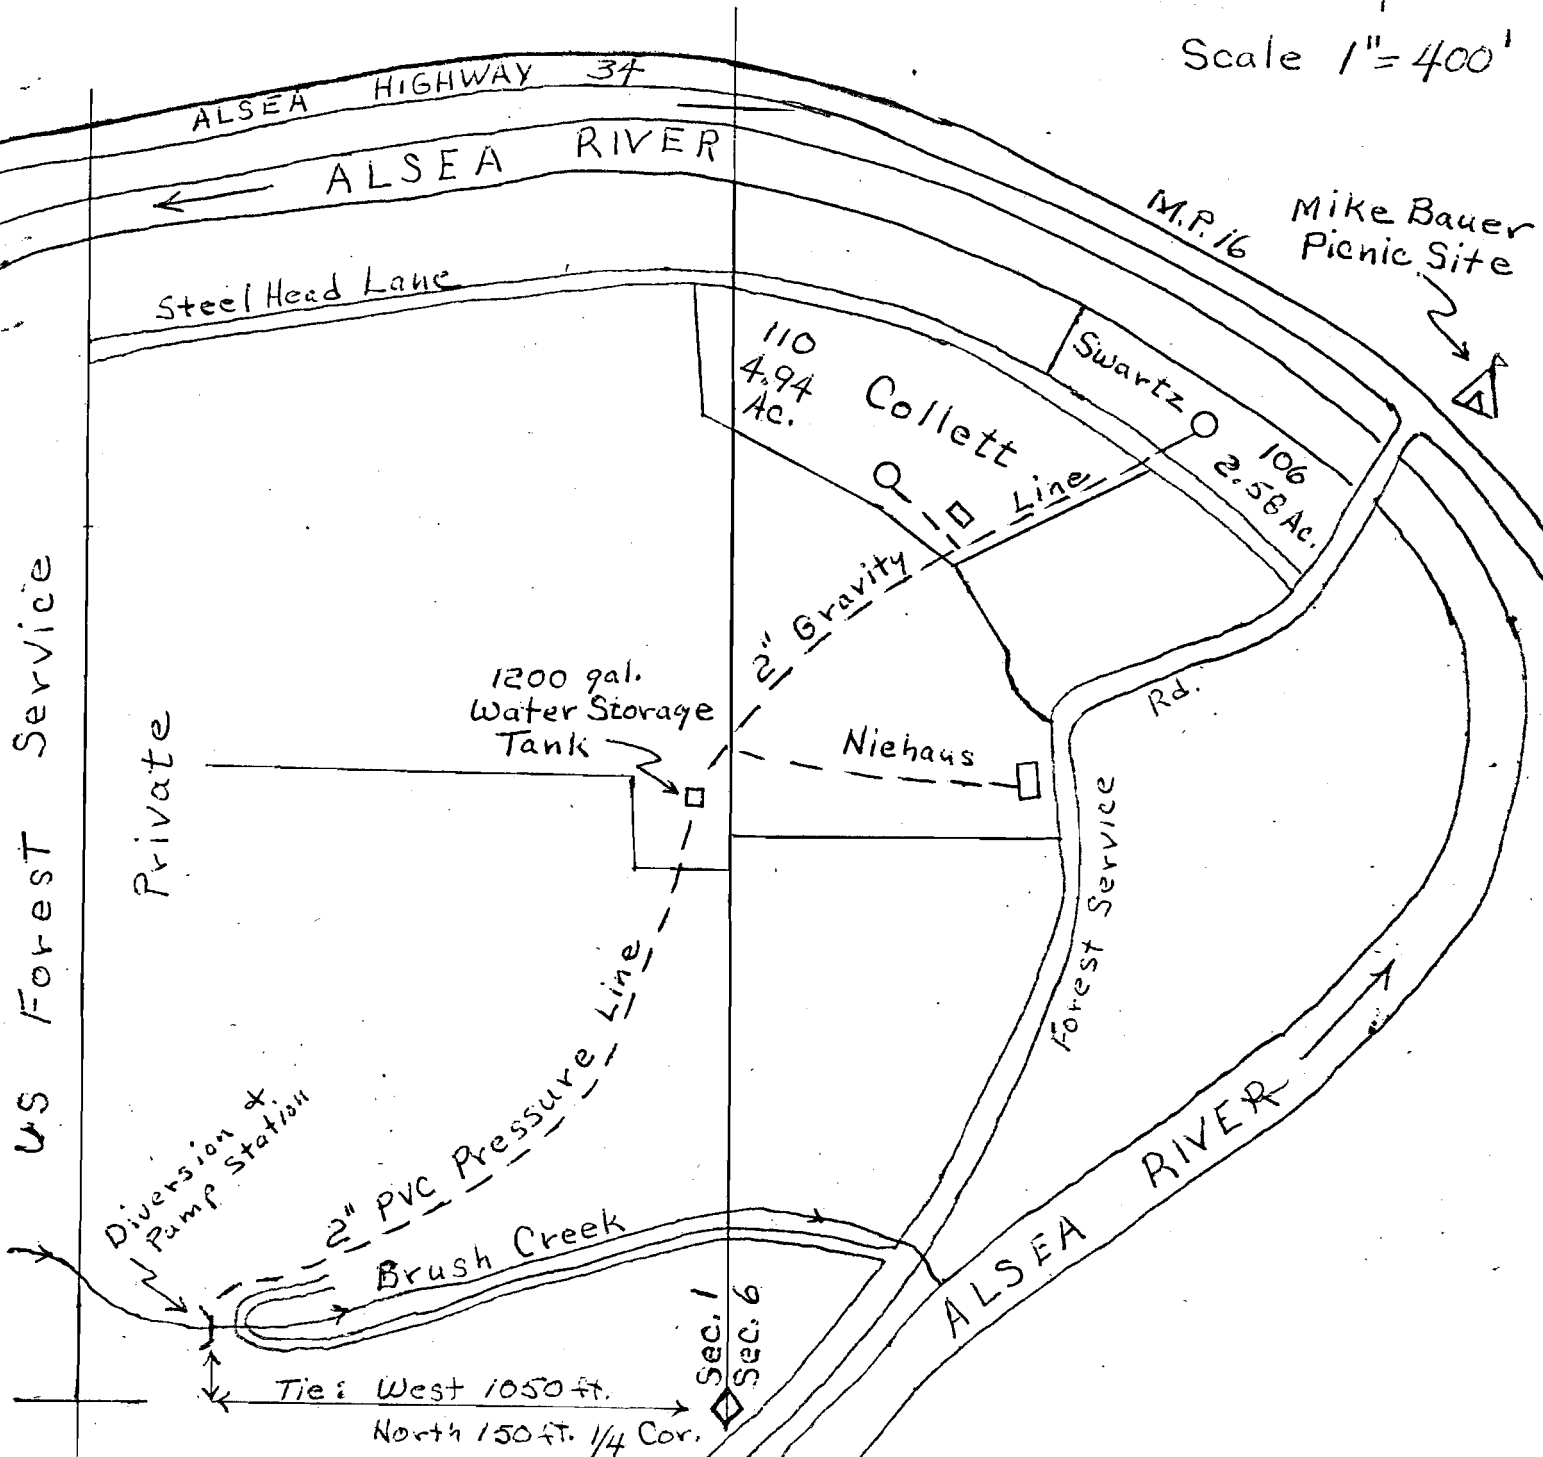

US Forest Service

Private

T14S, R10W

T14S, R9W

Application No. 56018
Permit No. 41943