


T4S. R10W W.M.

Application No. 55606 R-55605
Permit No. 41982 R 6647

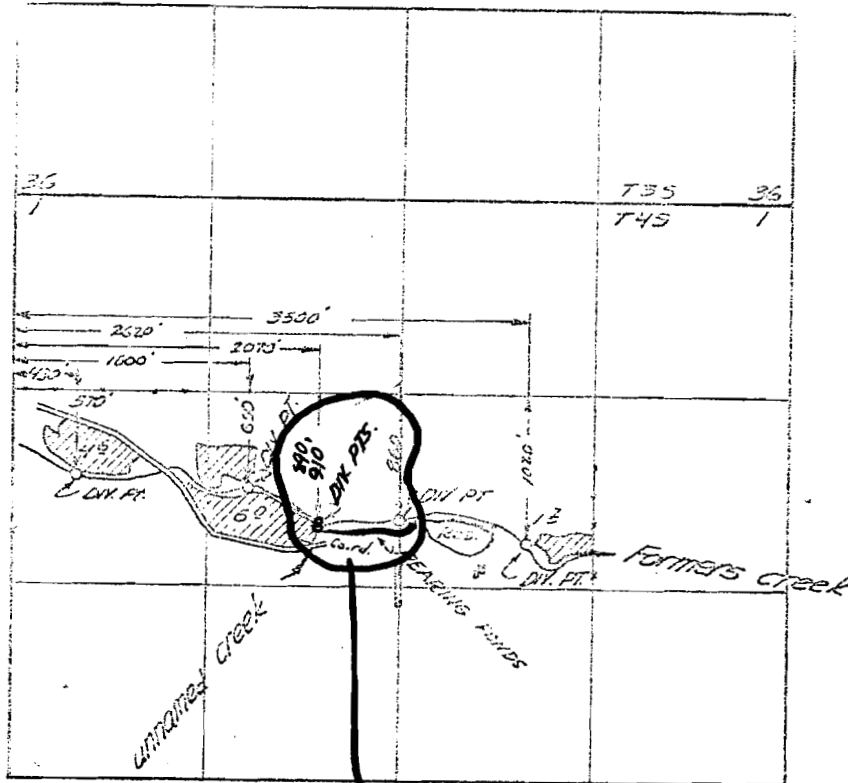

Rearing Ponds
Apps # 55606
Per # 41982

FINAL PROOF SURVEY
UNDER

38100 28918
38101 28401
Application No. R. 38913... Permit No. R. 3423...
IN NAME OF

ALBERT HENKIN

Surveyed Sept. 27, 1967, by V. Garner