



RECEIVED
MAR-31-1977
WATER RESOURCES DEPT
SALEM, OREGON

RECEIVED
FEB 24 1977
WATER RESOURCES DEPT
SALEM, OREGON

SECTION 27 T1S R8W WM

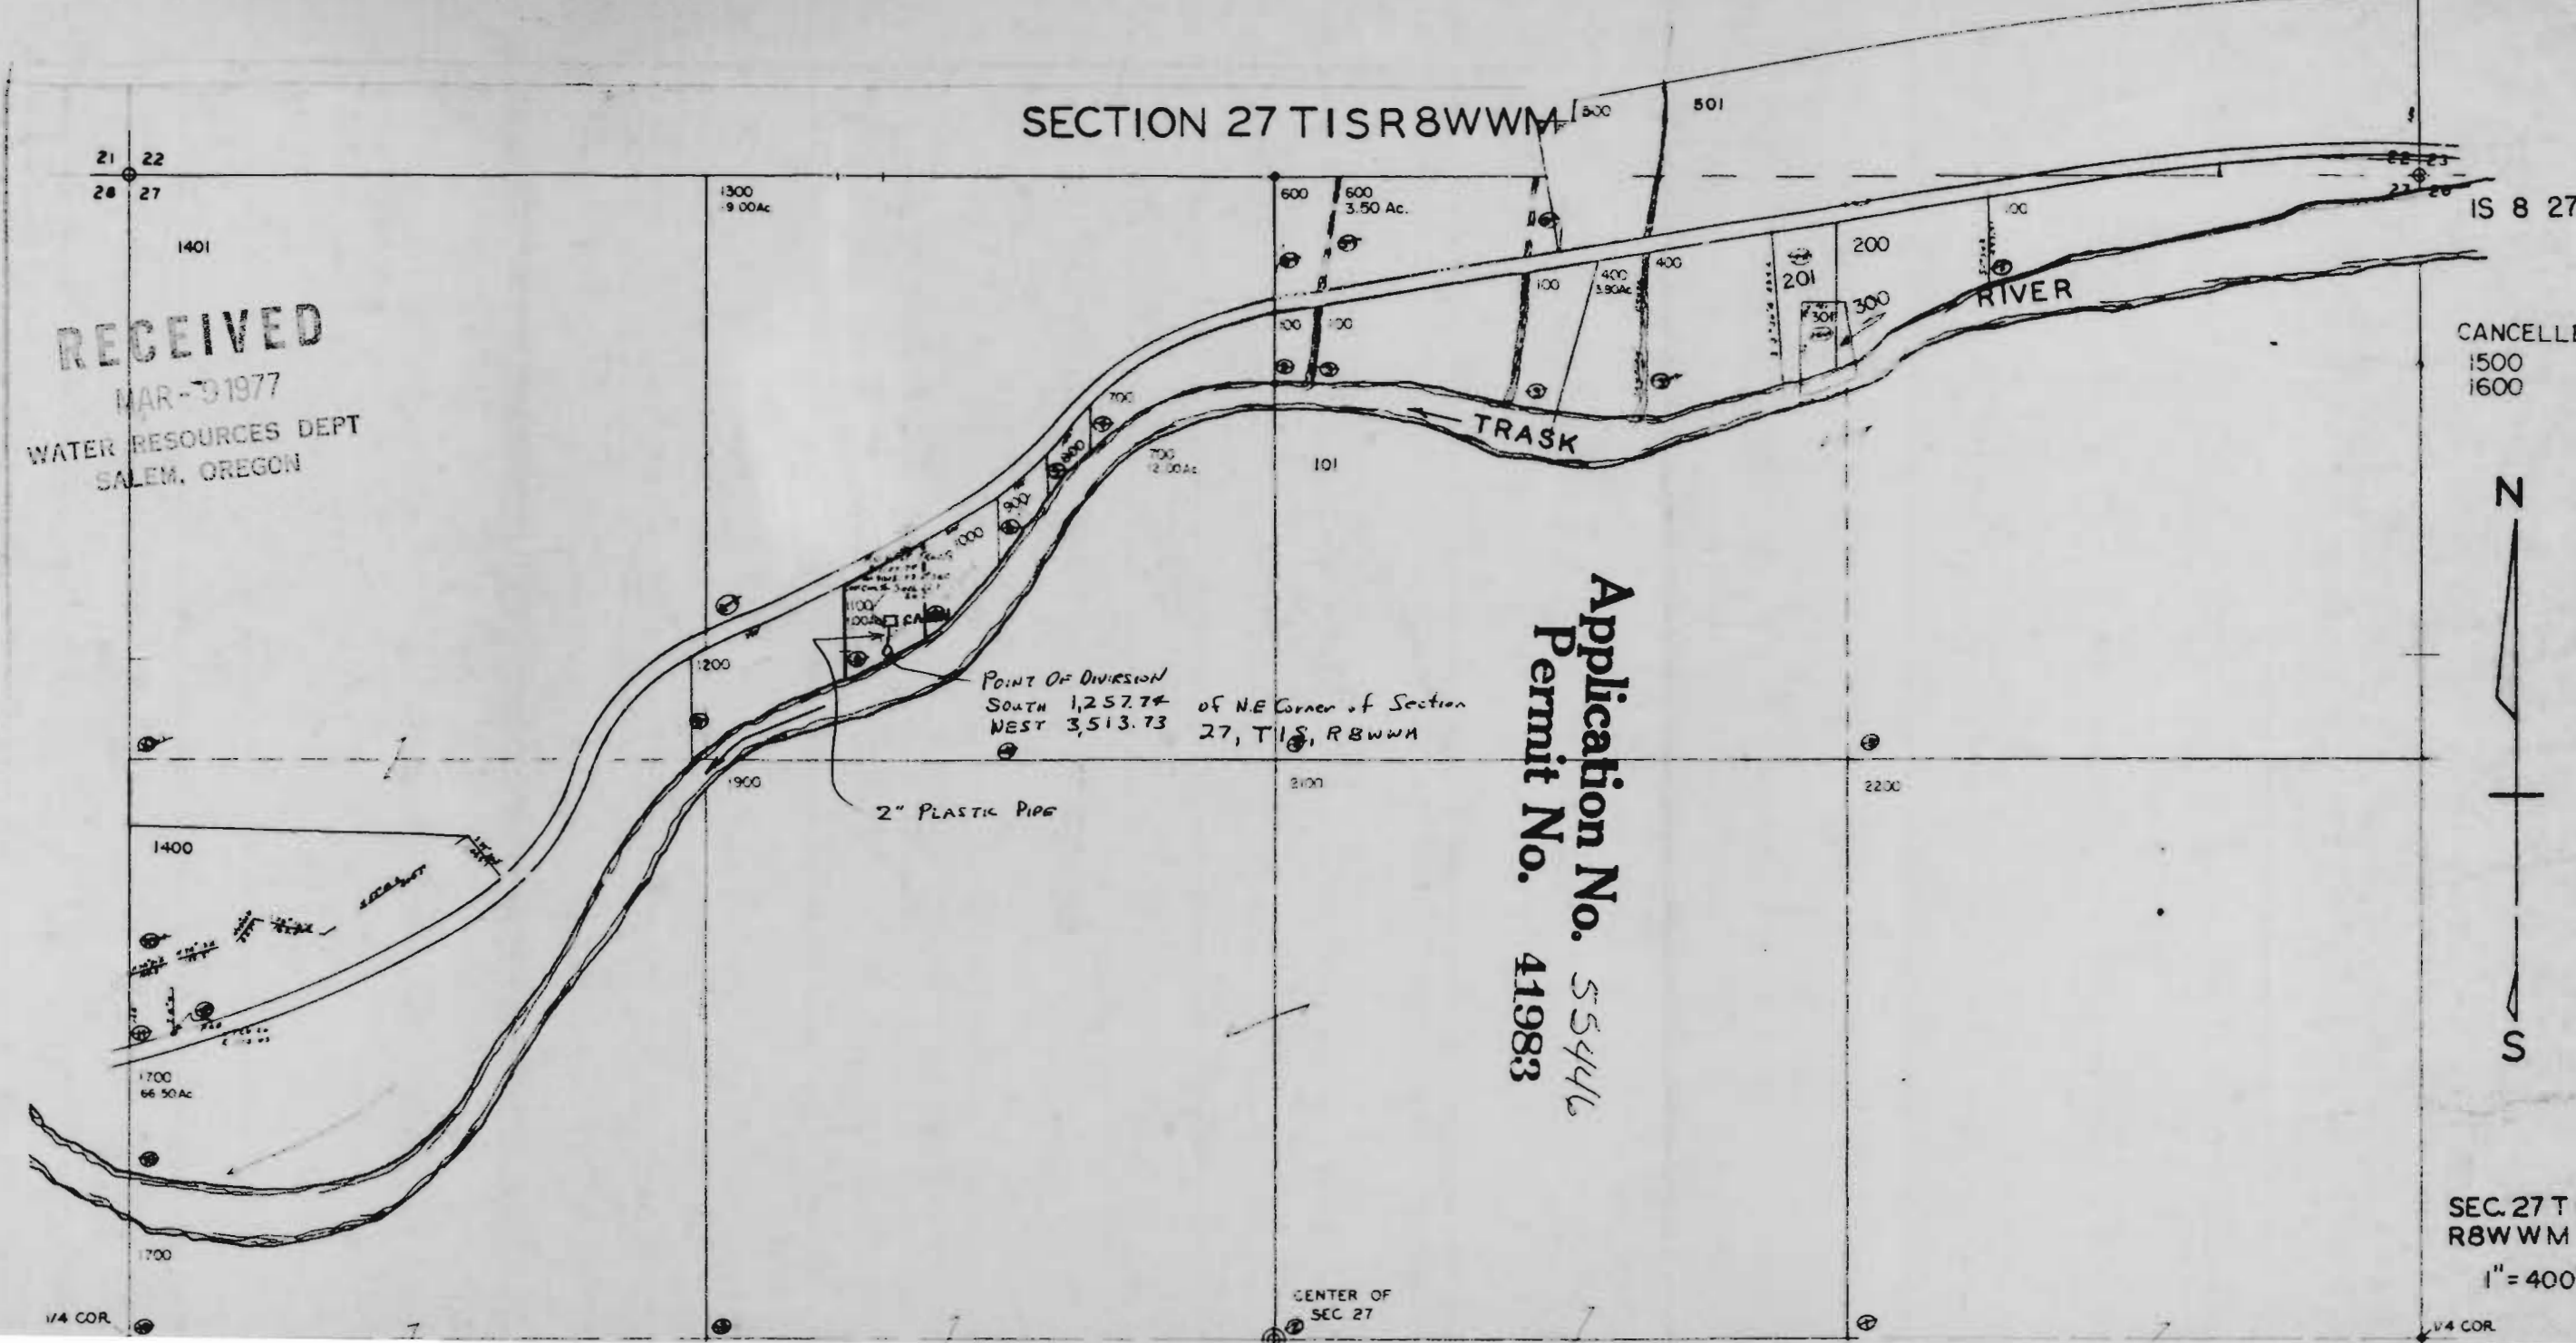

CANCELLED
1500
1600

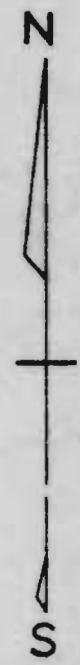

Application No. 55446
Permit No. 41983

SEC. 27 T1S
R8W WM
1" = 400'