


T.37S., R.6W., W.M.

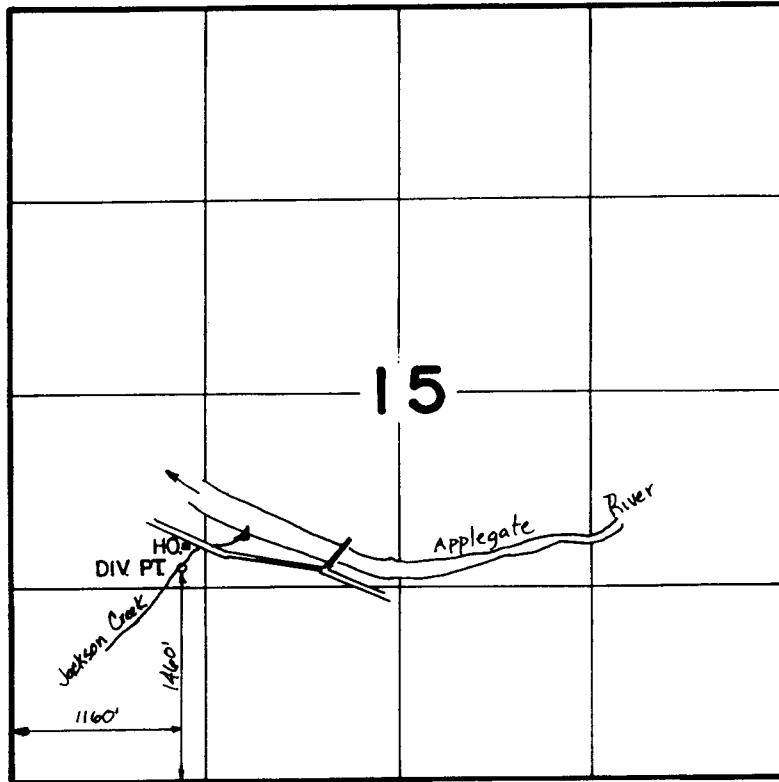

MAR 30 1988
REGISTERED
PLAT OFFICE

FINAL PROOF SURVEY
UNDER

Application No. ...55940... Permit No. ...42052...
IN NAME OF
HOMER C. RAND
.....
Surveyed ..Q.C.T. 24, 1983., by ..B.S. JAMES.....

B50-2-6 mc 2/84