


Permit: S 42054
Volume: 1
Strm: ROGUE R
Trib: PACIFIC OCEAN
Priority: 9/28/77

T. 35 S., R. 7 W., W. M.

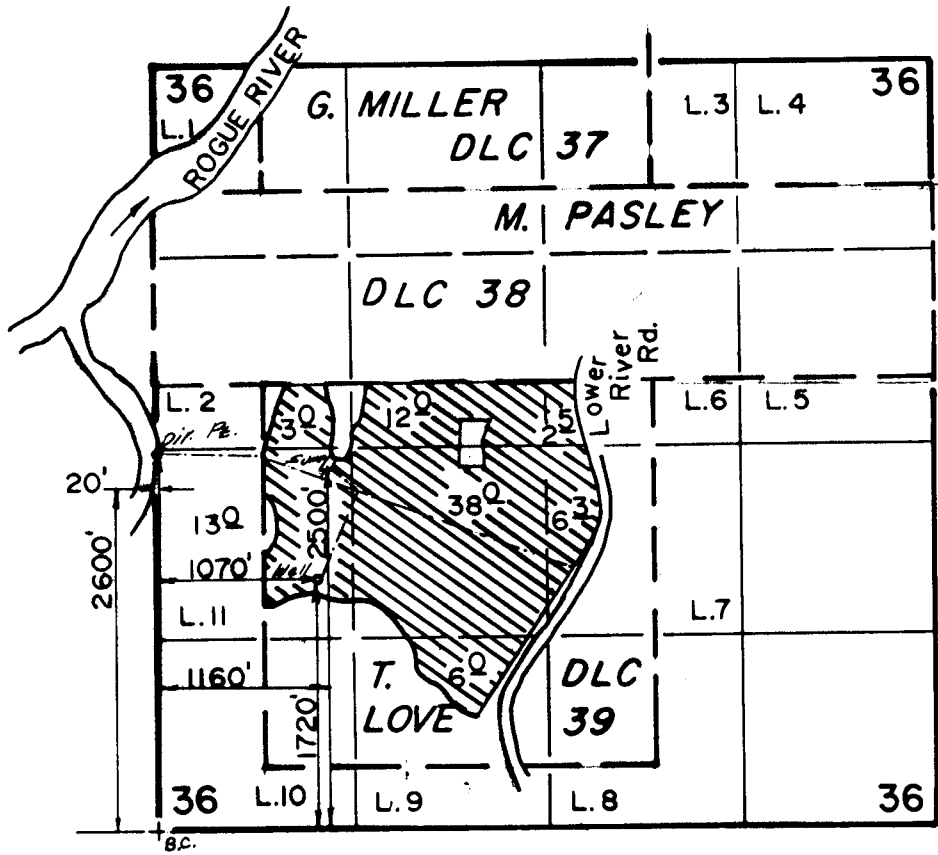

Scale: 1" = 1320'

FINAL PROOF SURVEY

UNDER

G-6968 G-6479

Application No. ~~56666~~ Permit No. 42054
IN NAME OF

ROBERT HOELLRICH

Surveyed OCT. 8... 1987, by B. S. JAMES...

APR 5 1989