


T. 37 S., R. 6 W., W.M.

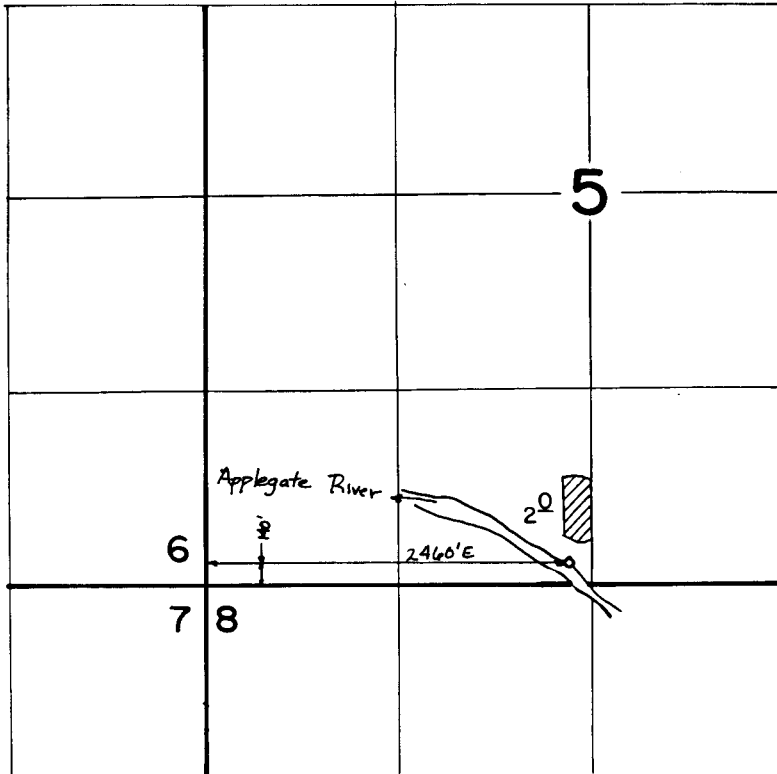

RECEIVED

APR 1 1987

WM. DIST. 14
GRANTS PASS, OR.

FINAL PROOF SURVEY
UNDER

Application No. 56224.. Permit No. 42060.....
IN NAME OF

.....**BILL & DONNA ROSE**.....

Surveyed AUG. 10. 1982., by B.S. JAMES.....