

18


T22S R7W SEC 19

Scale 1" = 400'

19

Application No. 56454

Permit No. 42070

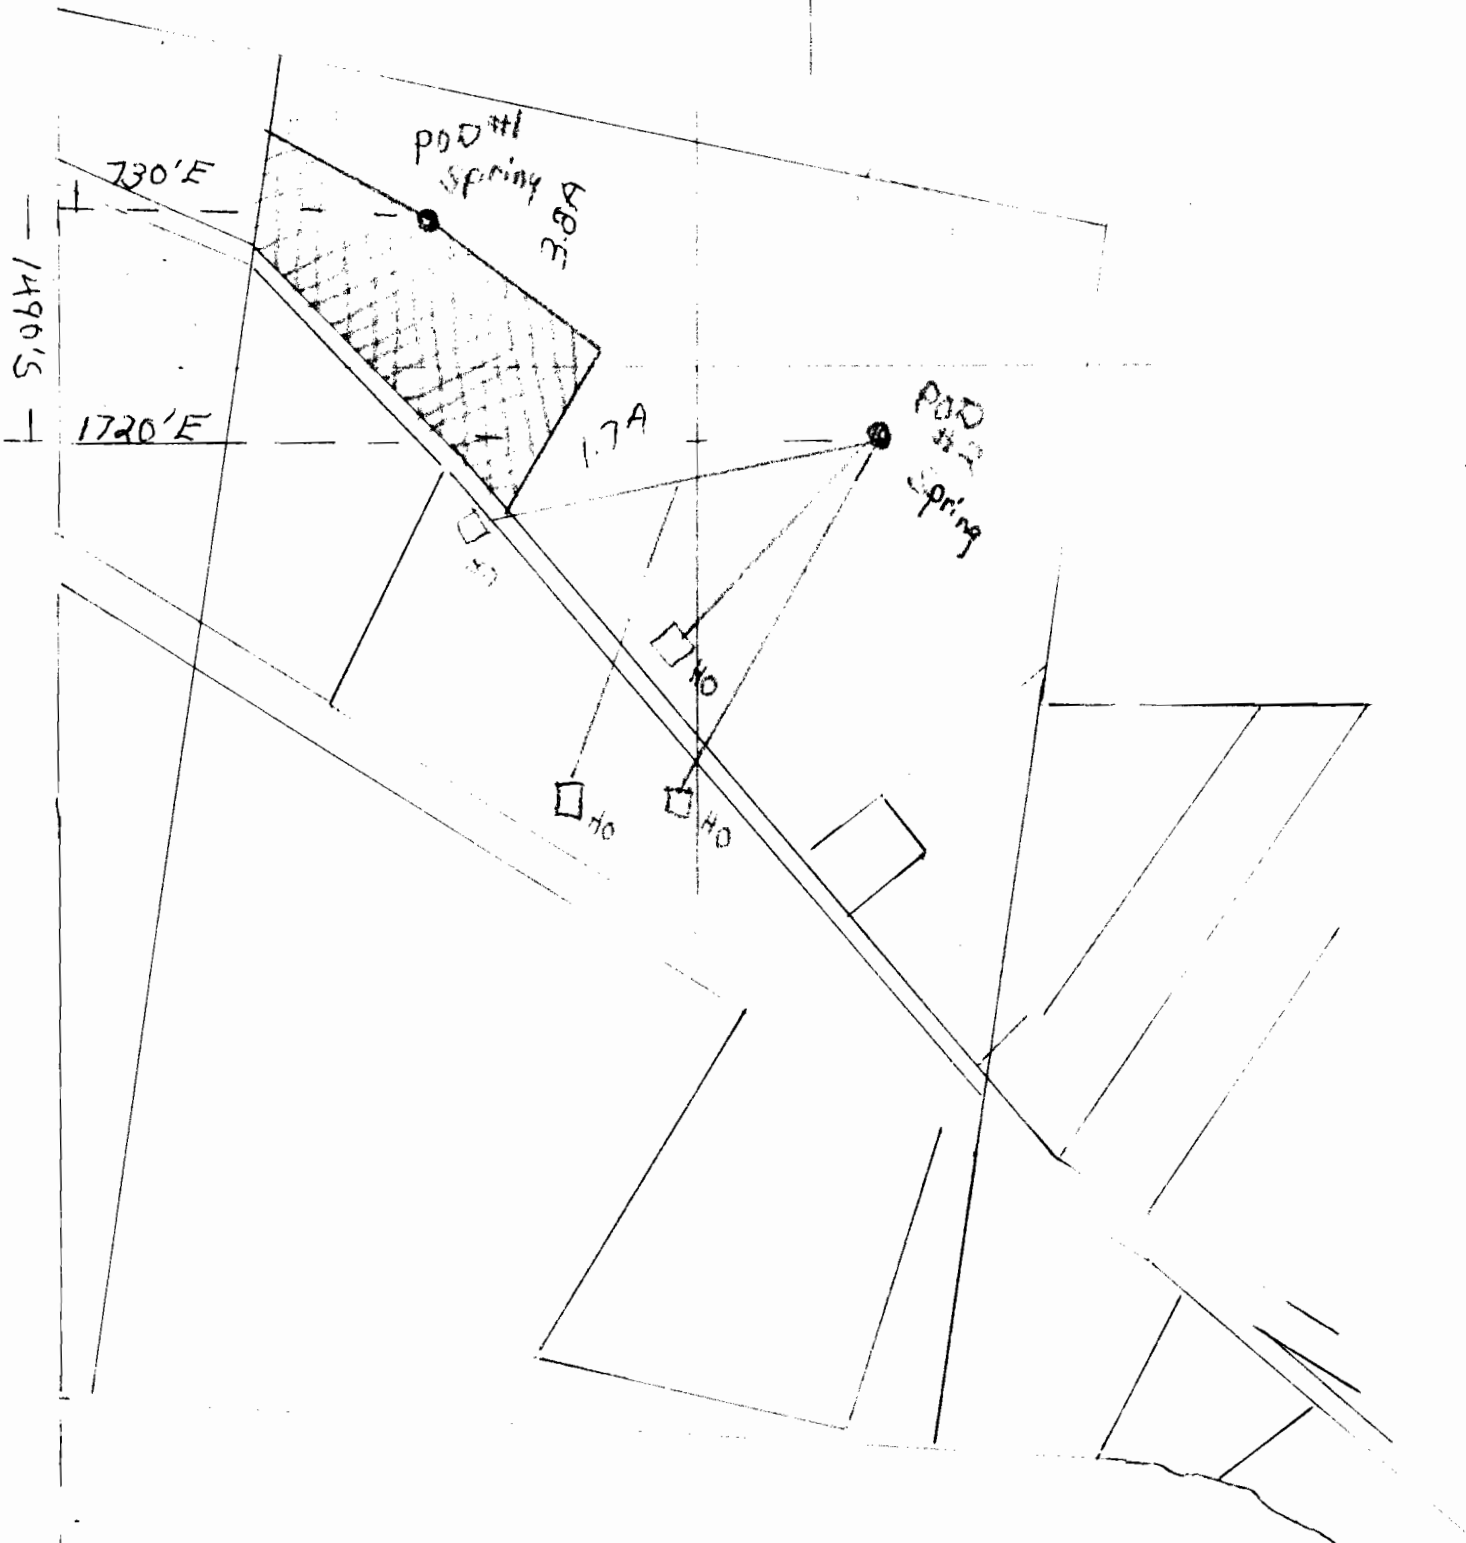

UMPQUA RIVER