


3

Application No. 56477
Permit No. 42080

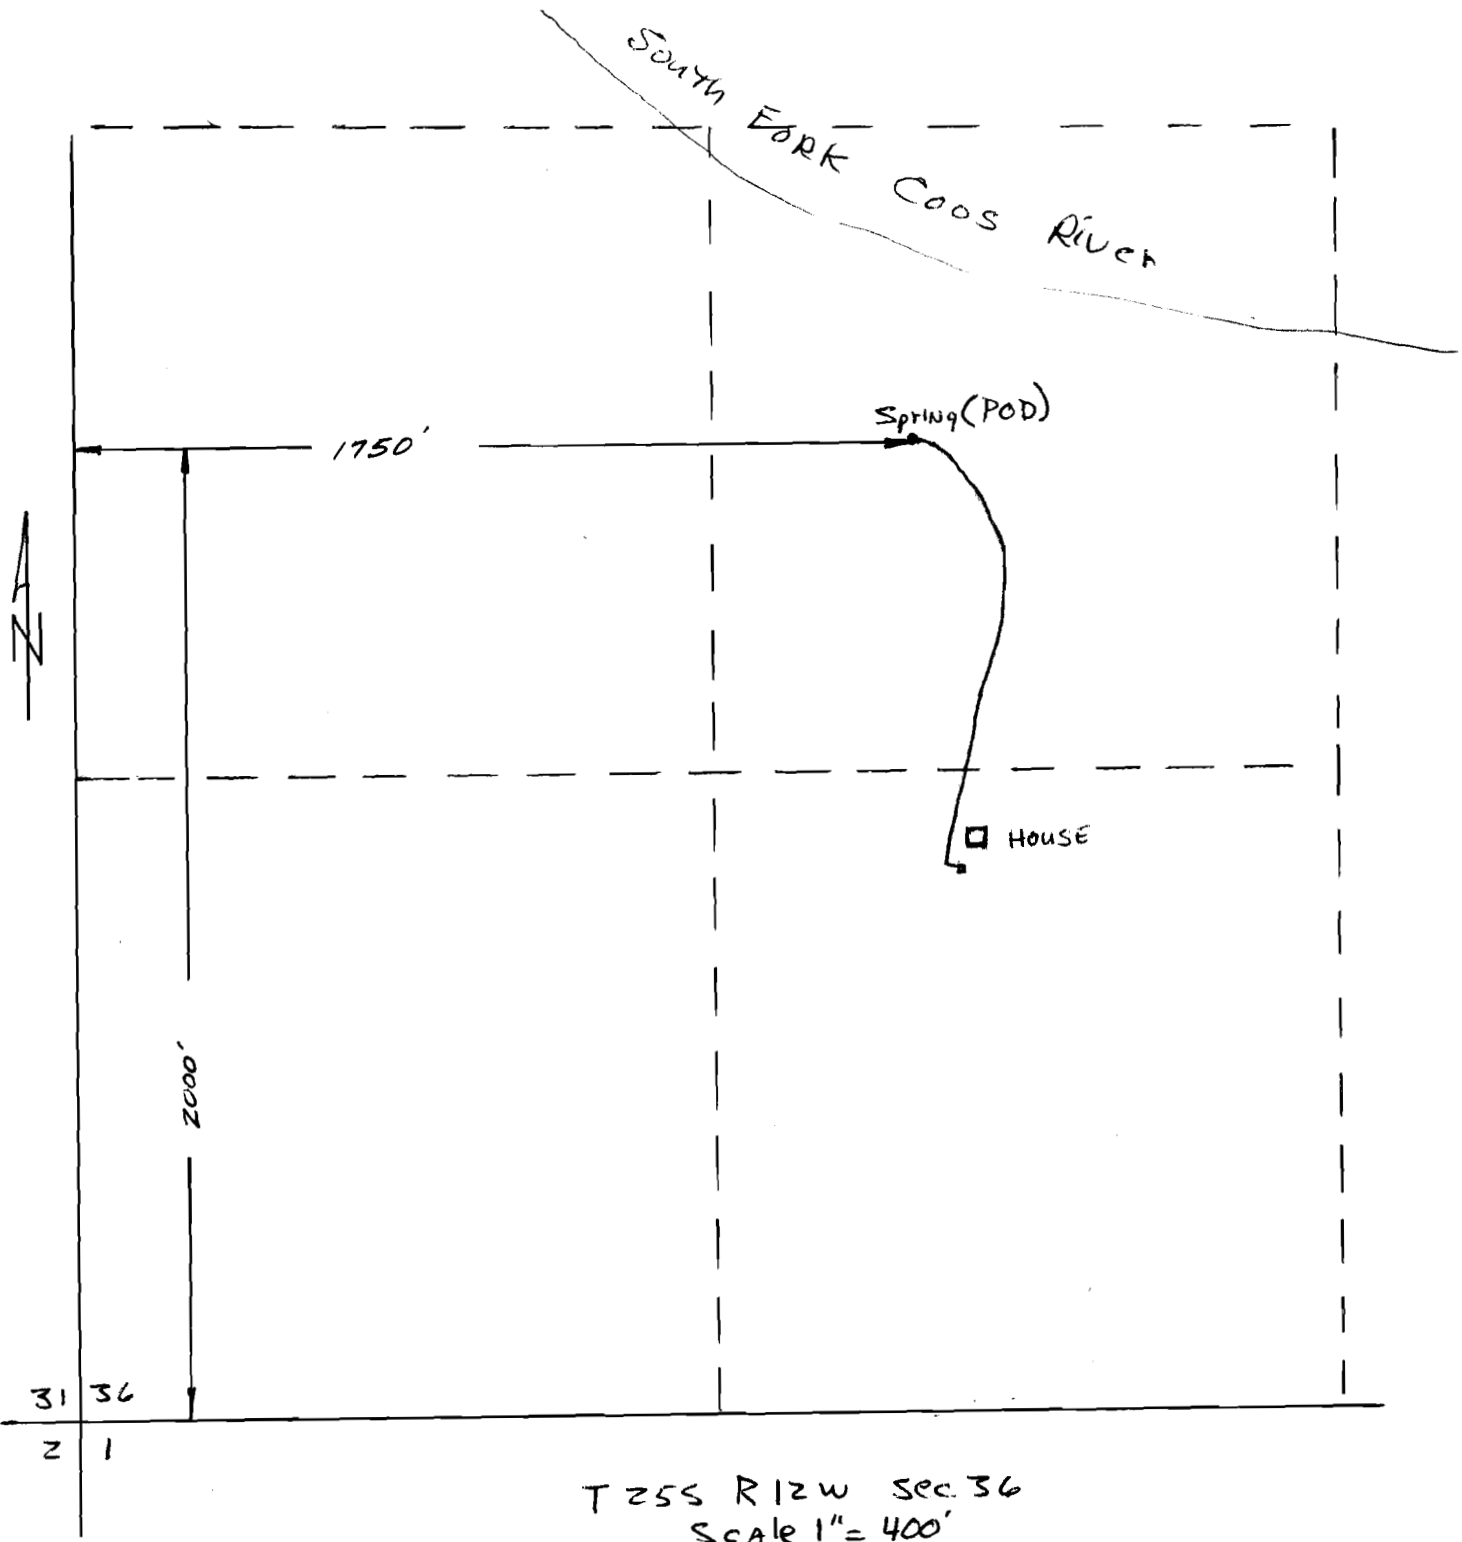

T 25S R 12W Sec 36
Scale 1" = 400'