


Application No. 56157
 Permit No. 42112

T. 3 S. R. 4 & 5 W. W. M.

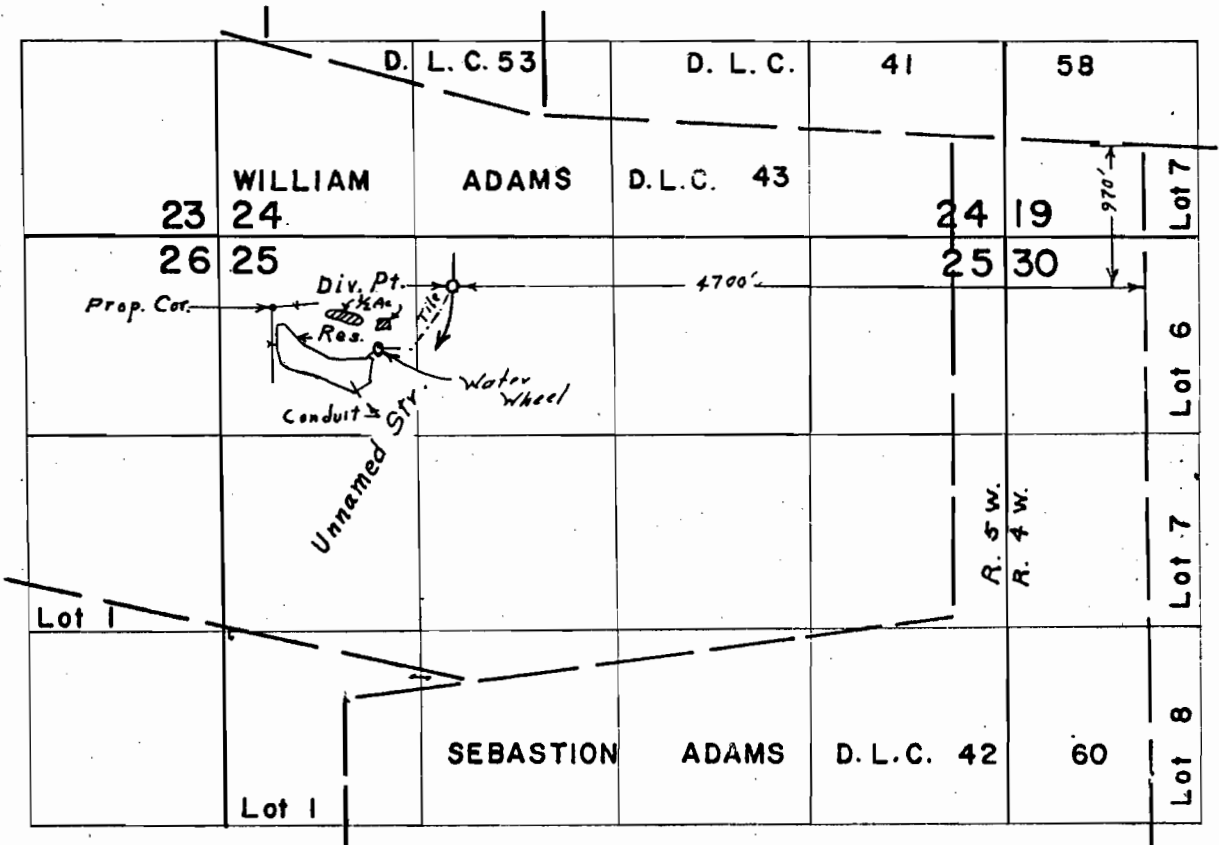

FINAL PROOF SURVEY
 UNDER

RECEIVED

JUL 5 1977

R-~~47559~~ R-~~5729~~
~~47560~~ ~~35610~~
 R-~~46816~~ R-~~5570~~
 Application No. ~~5617~~ Permit No. ~~54934~~
 IN NAME OF

WATER RESOURCES DEPT.
SALEM, OREGON

VICTOR THUMBERG

Surveyed ~~Oct 28, 1977~~ by L. E. Gould

THIS APPLICATION PREPARED BY
 FROM INFORMATION FURNISHED BY
 THE APPLICANT.