


# T. 34 S., R. 5 W., W. M.

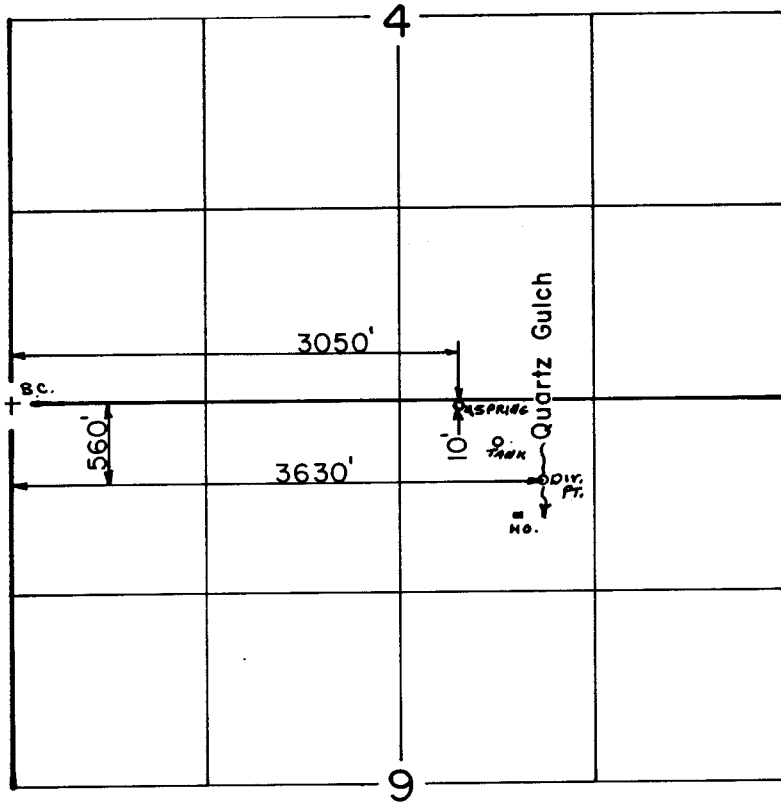

Scale: 1" = 1320'

## FINAL PROOF SURVEY UNDER

Application No. 562.7.2 Permit No. 42139....  
IN NAME OF

GORDON & ANE MARI ERICKSON

Surveyed MAY 11, 1989, by B. S. JAMES...