


T. 36 S., R. 7 W., W.M.

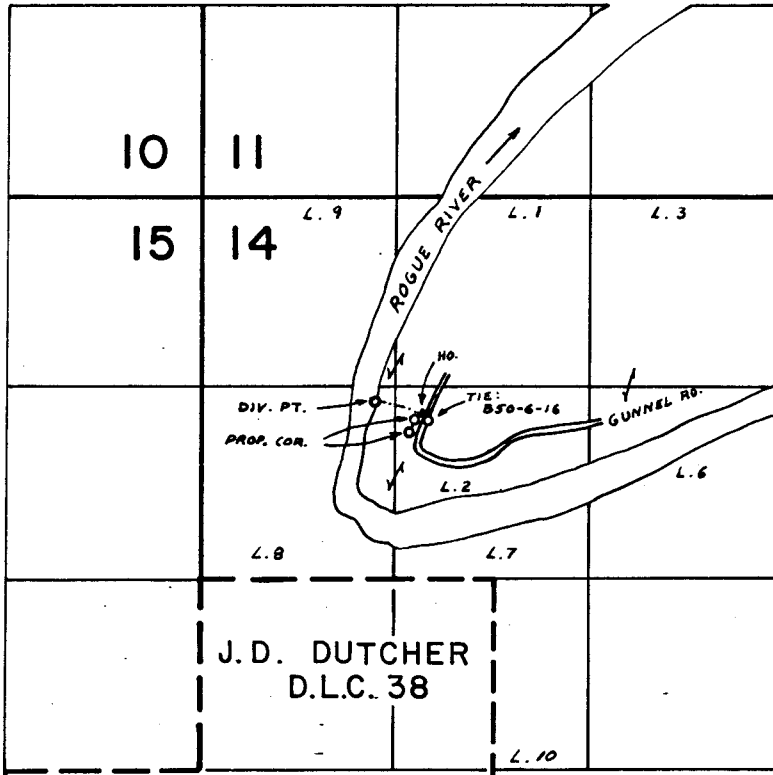

DIV. PT. LOC. : 90' S. & 130' W. FROM NW 1/4 COR. SEC. 14

FINAL PROOF SURVEY
UNDER

Application No. 55927 Permit No. 42147
IN NAME OF

CHARLES A. SMITH

Surveyed OCT. 23 1978, by B. SUND

RECEIVED
OCT 21 1981
WM. DIST. 14
GRANTS PASS, ORE

B50-6-16 8
P.T.S. - 1978-14-D