


Permit: S 42149
Volume: 6B
Strm: W FK WILLIAMS CR
Trib: WILLIAMS CR
Priority: 3/04/76

RECEIVED

OCT 18 1979

WM. DIST. 14
GRANTS PASS, ORE.

T. 39 S., R. 5 W., W.M.

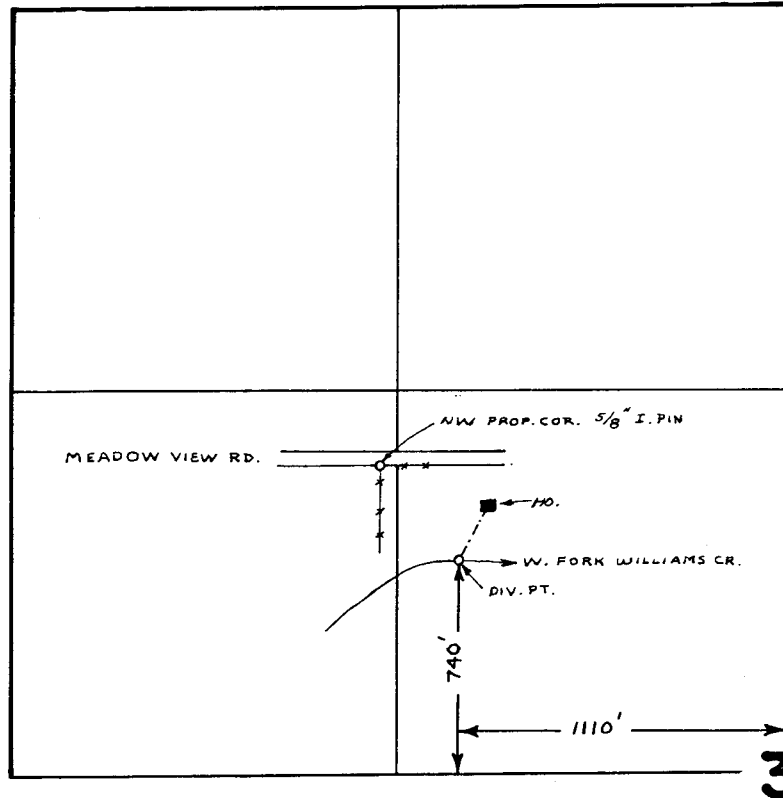

SCALE: 1" = 660 FT.

FINAL PROOF SURVEY
UNDER

TR-3357

Application No. 53980 Permit No. 42149
IN NAME OF

LARRY T. MCVEY

Surveyed SEPT. 15 1978, by B. SUND

P.T.S.-1978-14-C