


Application No. 56420
Permit No. 42153

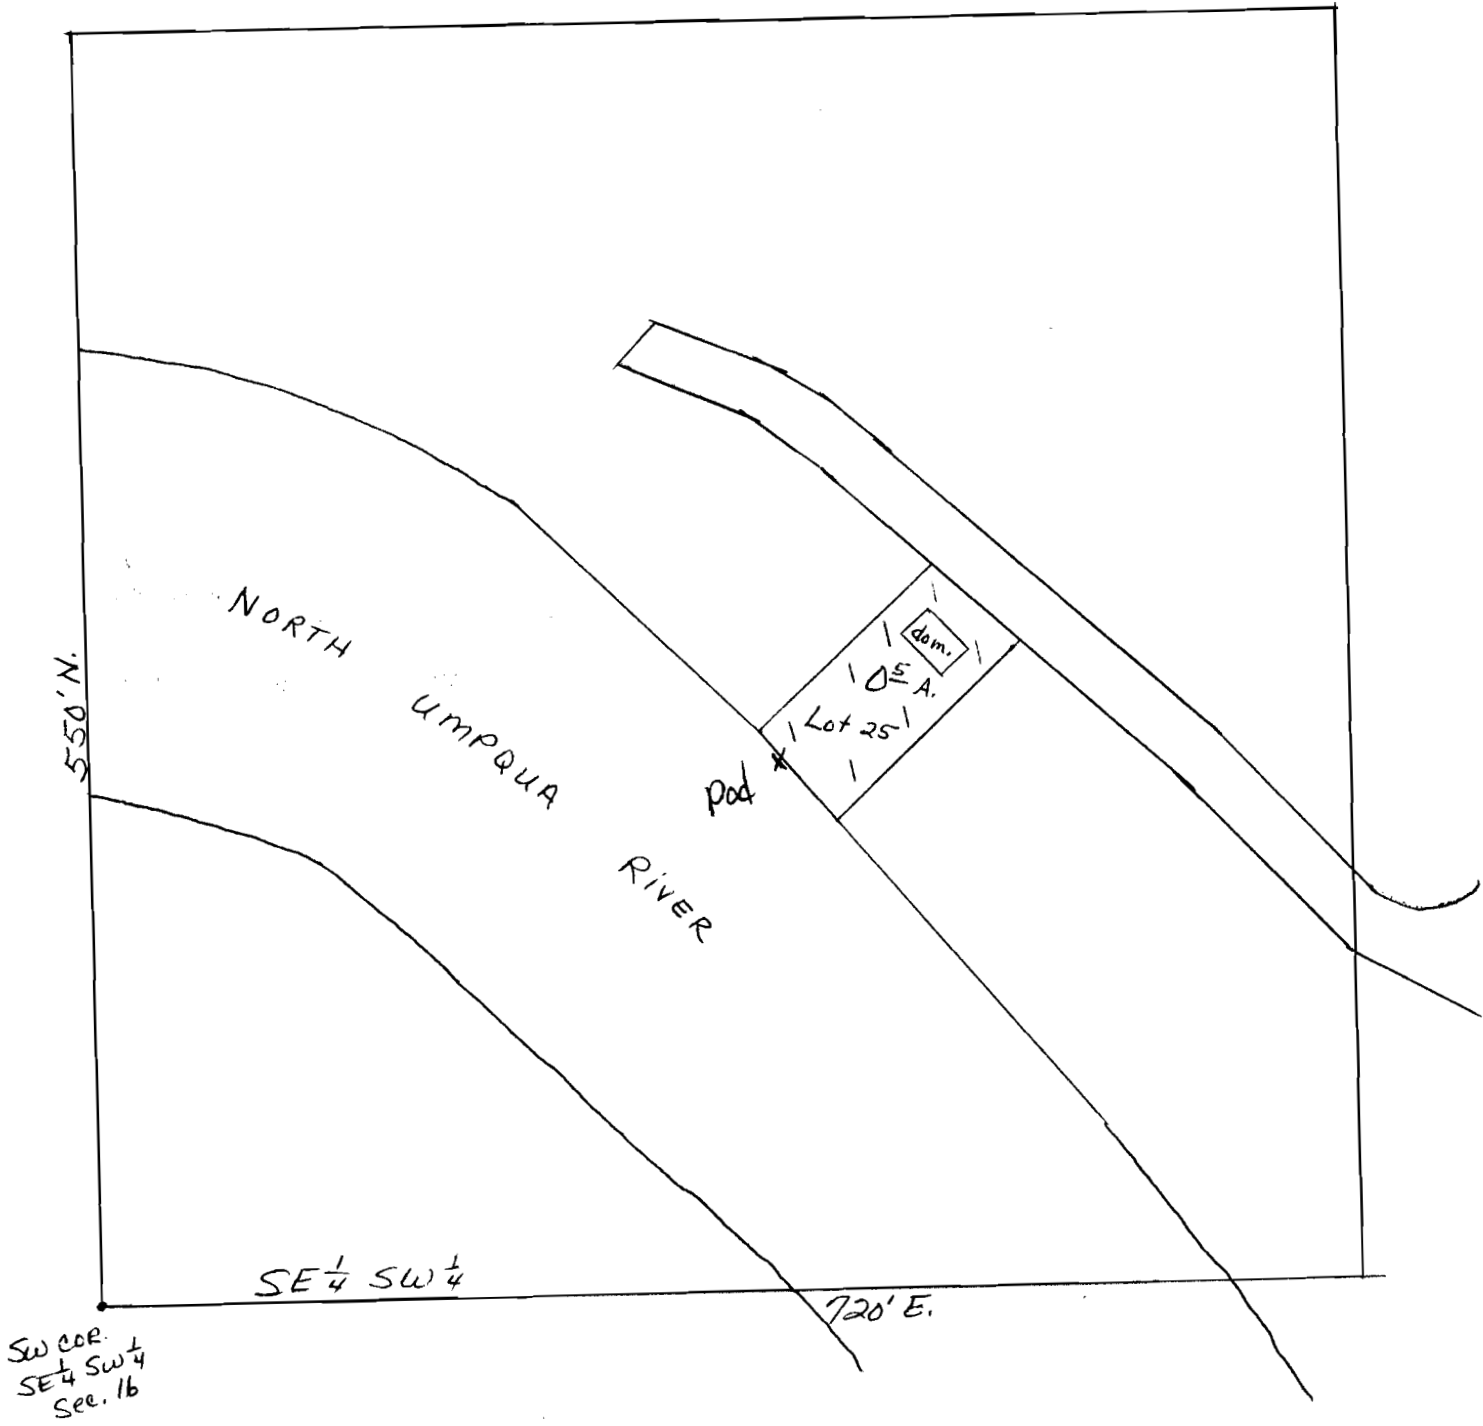

1" = 200'

T. 26 S., R. 5W, Sec. 16



THIS MAP PREPARED BY:

Gail M. Fry

FROM INFORMATION FURNISHED BY
THE APPLICANT.