


R.10 W
NE 1/4 SE 1/4 SEC. 31 T.3S. R.1
TILLAMOOK COUNTY


1"=100'

SEE MAP 3S 10 31AD

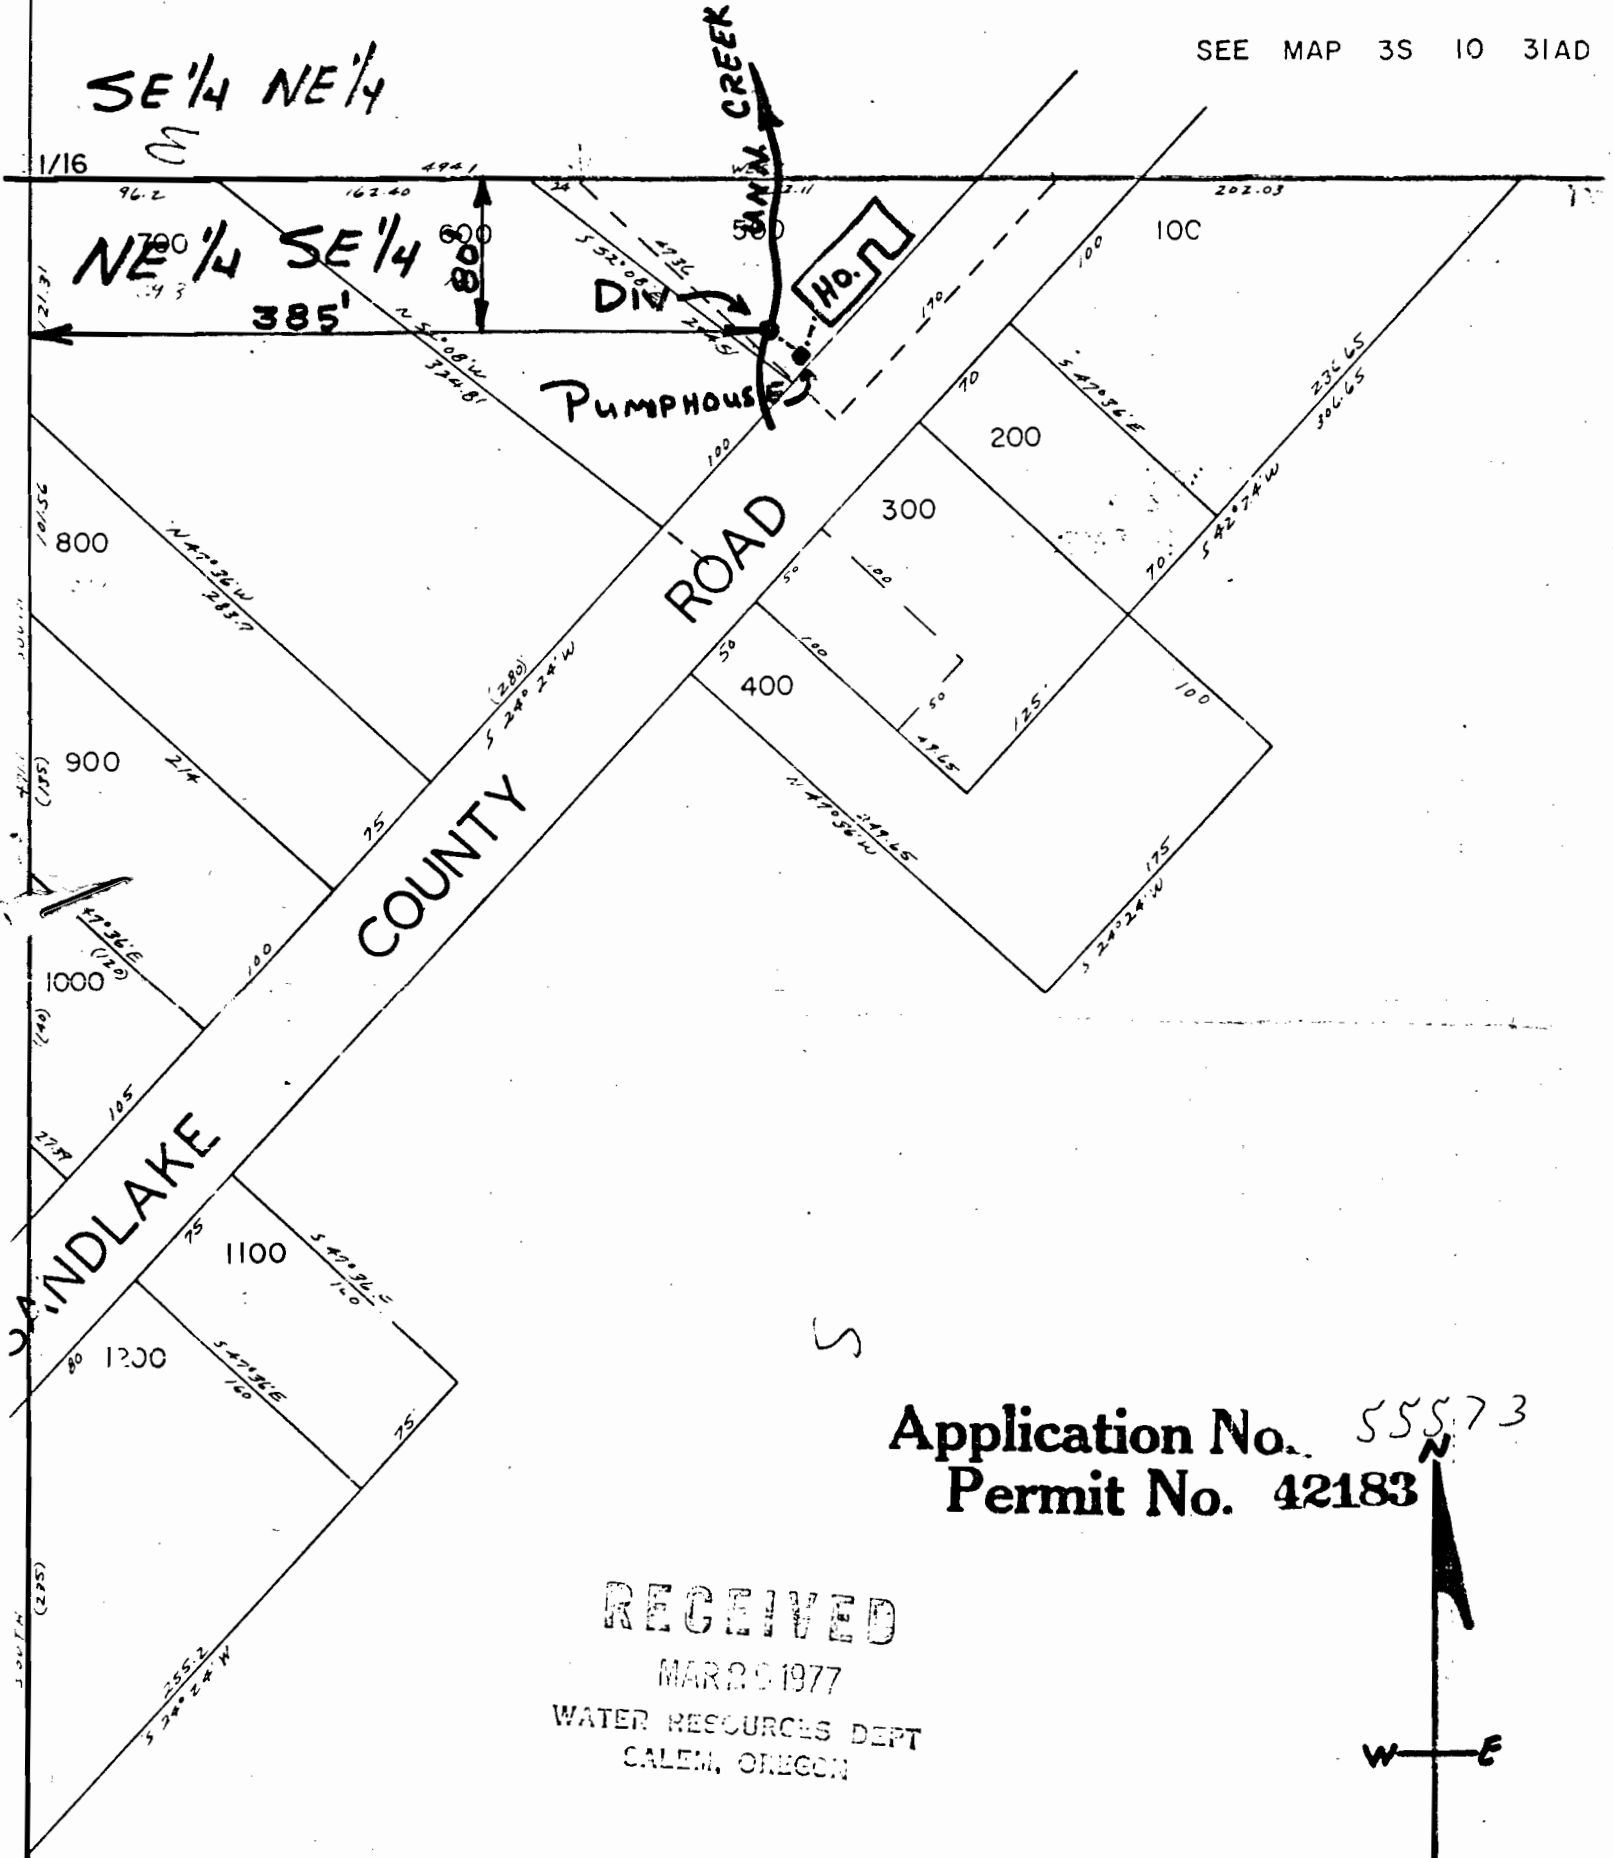

Application No. 55573
Permit No. 42183

RECEIVED
MAR 29 1977
WATER RESOURCES DEPT
CALEM, OREGON

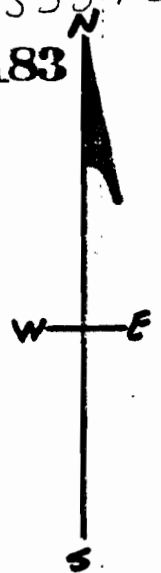

RECEIVED
NOV 3 1977
WATER RESOURCES DEPT
CALEM, OREGON