


T.39S., R.8W., W.M.

RECEIVED

MAY 20 1985

PLA. DIST. 14

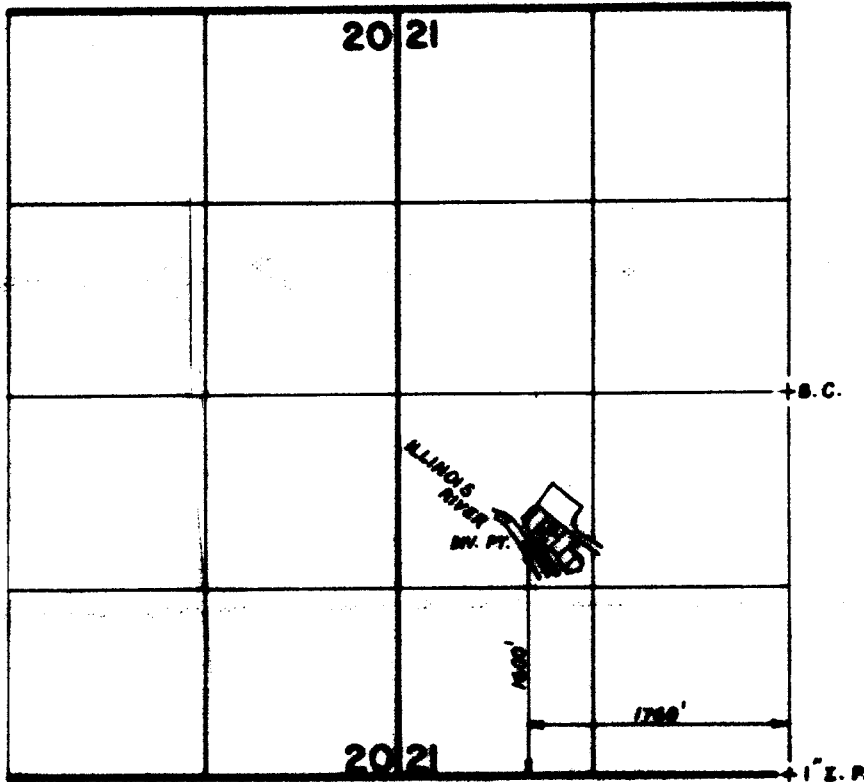

SCALE: 1" = 1320'

FINAL PROOF SURVEY
UNDER

c-52778

Application No. **55946** Permit No. **42224**
IN NAME OF

OREGON STATE PARKS & RECREATION BRANCH

Surveyed **AUG. 3** 19**78**, by **BRUCE R. SUND**
AUG. 26 82 **BRUCE R. SUND**