


T. 1 N. R. 12 E. W.M.

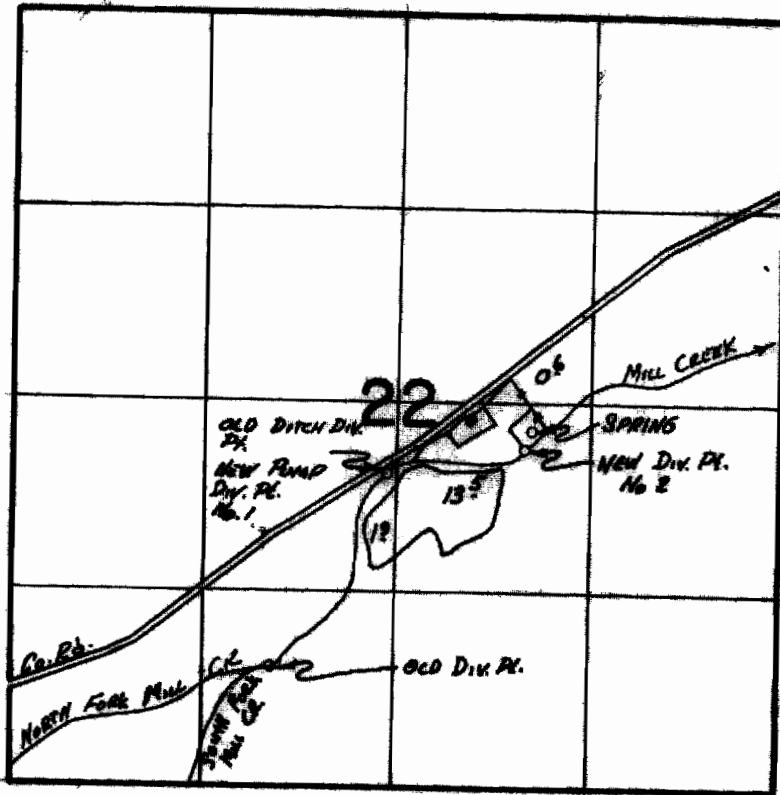

DIV. Pts. Loc. : OLD DIV. 820' N & 1780' E ; DIV. No. 1
2150' N & 2560' E ; DIV. No. 2 2930' N & 9510' E
SPRING Loc. 2460' N & 9530' E Acc FROM SW COR
9& 22

APPLICATION MAP FOR
MICHAEL T. PETERSON

SCALE 4" = 1 MILE

THIS APPLICATION PREPARED BY:

Thomas J. Ral

FROM INFORMATION FURNISHED BY
THE APPLICANT.