



T. 35 S., R. 8 W., W.M.

Sec. 1

SW 1/4 NE 1/4

RECEIVED

FEB 28 1989

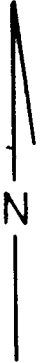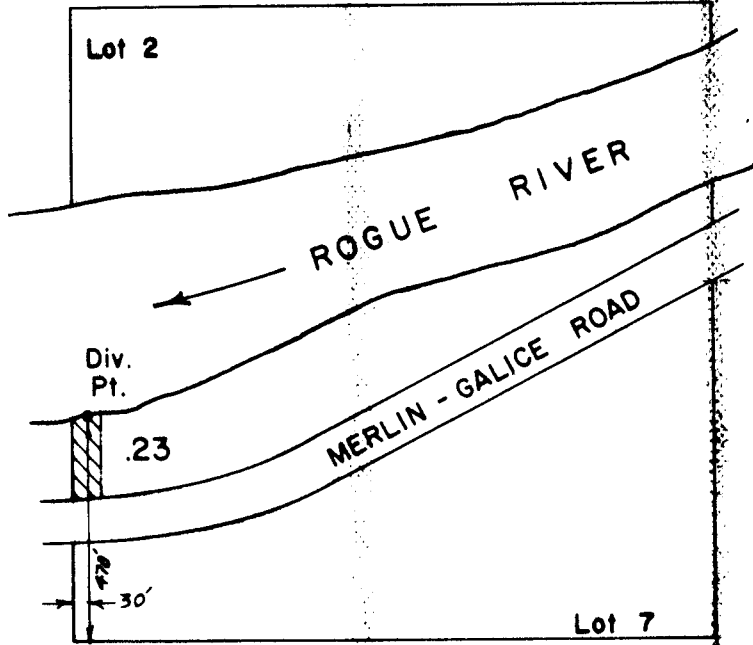

SCALE 1" = 400'

FINAL PROOF SURVEY
UNDER

Application No. 56238.. Permit No. 42281.....
IN NAME OF

.....MARY LOUISE LENT.....

Surveyed JUNE 27, 1984, by B.S. JAMES.....